

# Final Proof Survey Map T 12 S R 1 W, W.M.

This map is not intended to provide legal dimensions or locations of property ownership lines.

SUPPLEMENTAL  
IRRIGATION  
Permit#S-54471  
In the Name of  
Mallard Creek LLC



Permit S-54471  
Application S-84379  
In the name of  
**Mallard Creek LLC**


Prepared by  
Walter L. Trimmer  
CWRE #332  
Trimmer Engineering Inc.  
3924 NW Walunt Place  
Corvallis, OR 97330  
541-754-2819

Scale 1" = 1320'

October 28, 2010  
Rev. 5 Feb 2011 acre div & "meter"

Layout: S54471  
File: Mallradgc.dwg  
Based on USGS  
One Horse Slough Quad


DWG 1 of 1

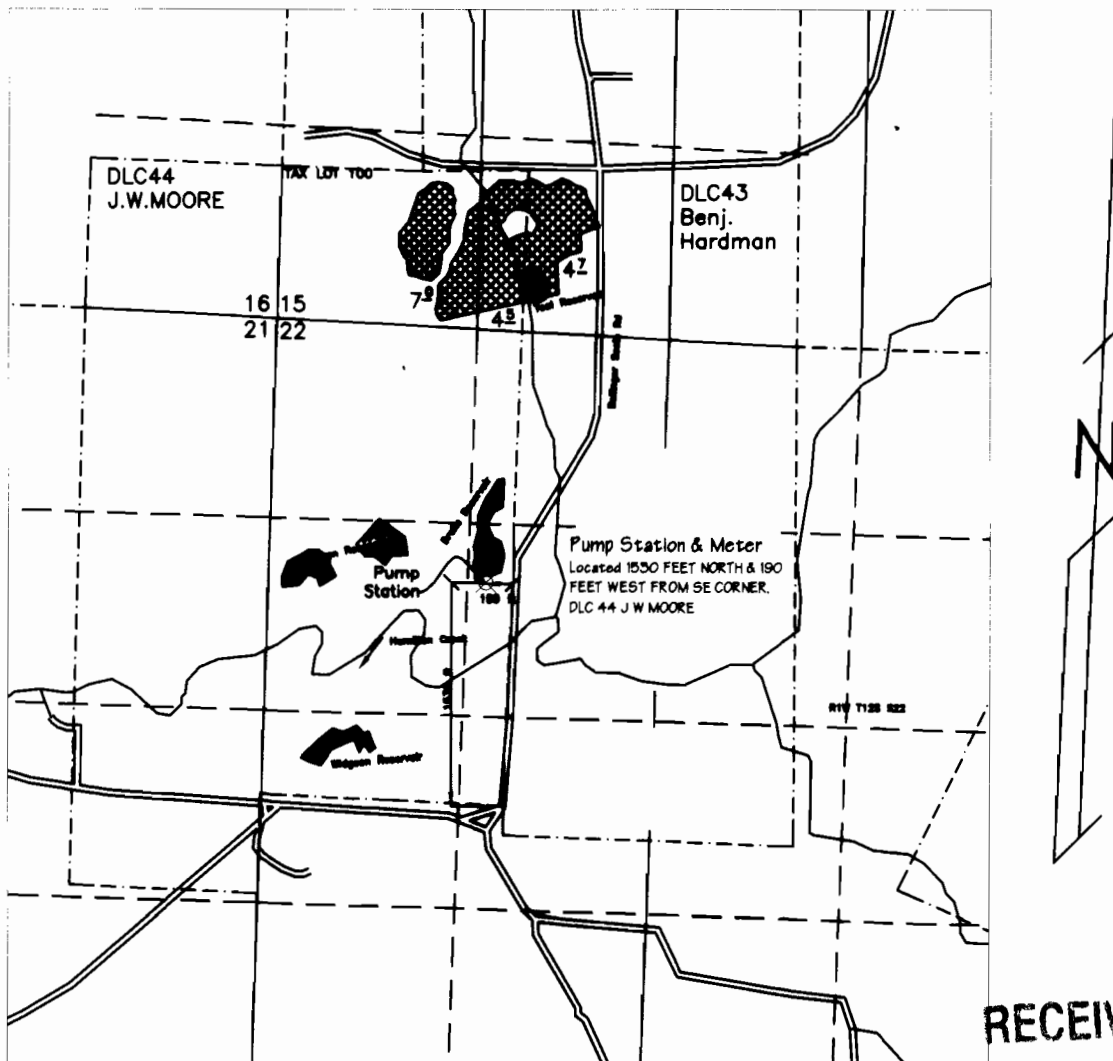

RECEIVED

FEB 28 2011

WATER RESOURCES DEPT  
SALEM OREGON

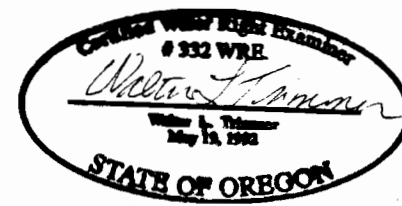

RENEWED 6/30/2012