


Final Proof Survey Map
T 12 S R 1 W, W.M.

This map is not intended to provide legal dimensions or locations of property ownership lines.

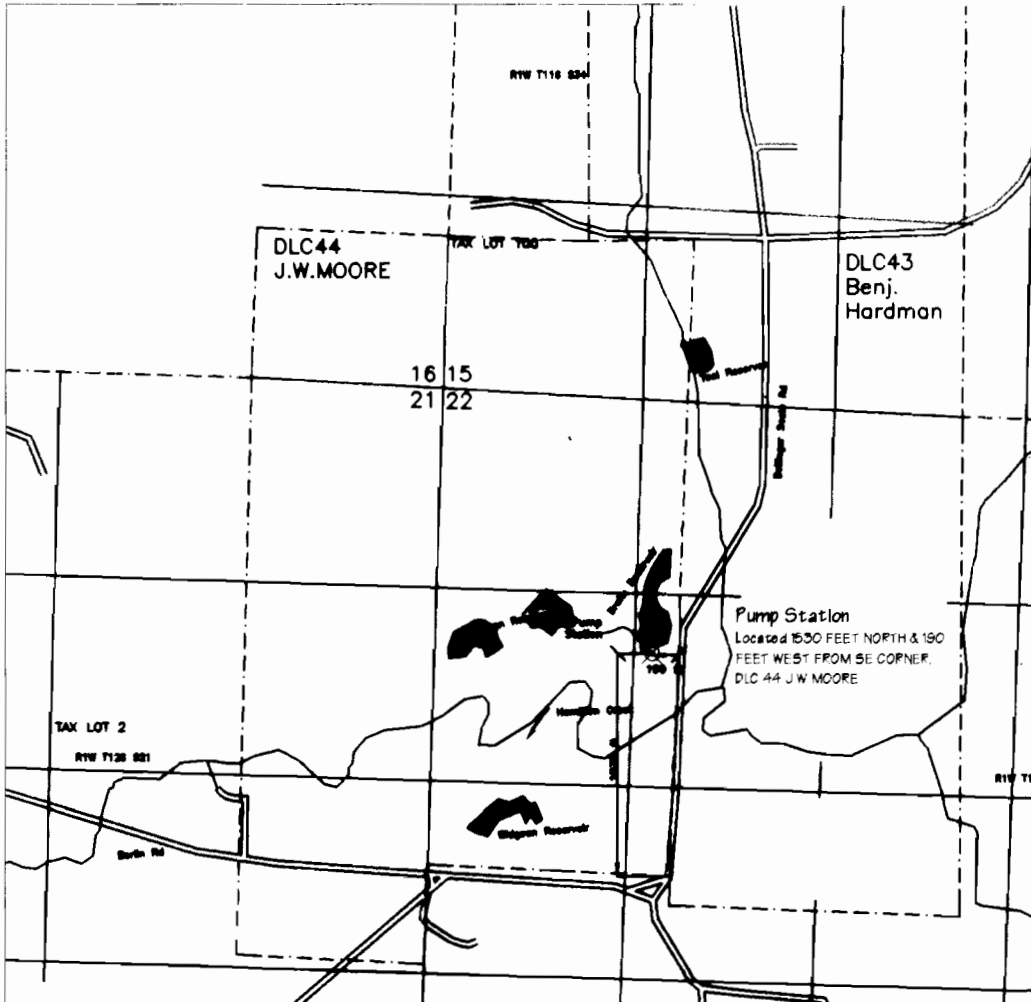

Transfer T-8456

In the name of
Mallard Creek LLC

Final Proof Survey

Prepared by
Walter L. Trimmer
CWRE #332

Trimmer Engineering Inc.
3924 NW Walurt Place
Corvallis, OR 97330
541-754-2819

Scale 1" = 1320'

October 26, 2010


Layout: FPS Map

File: Mallraddgc.dwg

Based on USGS

One House Slough Quad

DWG 1 of 1

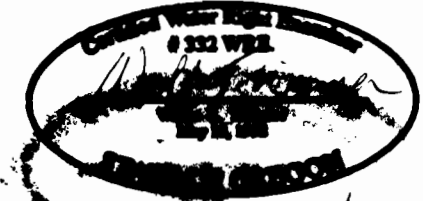

Revised 6/30/2012

RECEIVED

NOV 03 2010

WATER RESOURCES DEPT
SALEM, OREGON