

N 1/4 COR, SEC 29

1/16 COR

**RECEIVED**

**MAR 30 1998**

**WATER RESOURCES DEPT.  
SALEM, OREGON**

PUMP IS LOCATED  
285' S, 600' E, OF N 1/4 COR  
SEC 29, T2N, R48E, WM.

NEW POINT OF DIVERSION  
IS 250' S, 550' E OF  
N 1/4 COR

1 1/2" POLYETHYLENE  
SUCTION PIPE TO  
RIVER.

TAX LOT 300 2N 48 29A  
IN SEC. 29 T2N R48E  
IN THE NW 1/4, NE 1/4.

1.0 ACRE WATER RIGHT

IMNAHA RIVER

2.0 AC

1.0 AC

COUNTY

ROAD

THIS TRANSFER IS FOR A  
1.0 ACRE PORTION OF A 4.0  
ACRE WATER RIGHT, CERT  
9380, PROOF # 108


OLMSTEAD DITCH



1" = 200'

THIS MAP IS BASED ON THE  
WALLOWA COUNTY ASSESSOR  
MAP AND IS PREPARED FOR WATER  
RIGHT PURPOSES ONLY. IT SHOULD NOT  
BE USED FOR PROPERTY LOCATION PURPOSES.

FORMER DIVERSION POINT  
FOR OLIMSTEAD DITCH,  
PROOF #108 CERT #9380, 1904  
IN SW 1/4, NE 1/4, SEC 29

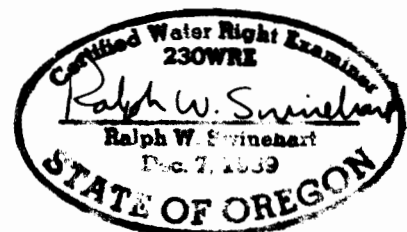

**FINAL PROOF SURVEY  
CHANGE IN POINT OF DIVERSION  
T-6922**

**IN SECTION 29, T2N, R48E, WM WALLOWA COUNTY  
FOR: CORA BOYCE**

DATE  
8-97  
JOB  
DESIGN  
RWS  
DRAWN  
TCB

**WALLOWA MOUNTAIN  
ENGINEERING**

P.O. Box 246  
ENTERPRISE, OREGON 97828  
426-4985

REVISIONS  
  
SHEET  
1 of 1