

N 1/4 COR. SEC 29

1/16 COR

RECEIVED

MAR 30 1998

WATER RESOURCES DEPT.
SALEM, OREGON



1" = 200'

PUMP IS LOCATED
680' S, 410' E, OF N 1/4
COR SEC 29, T2N, 48E

NEW DIVERSION PT.
IS 670' S, 385' E
OF N 1/4 COR.

3" FLEXIBLE
SUCTION PIPE 25'
LONG TO RIVER

5HP
PUMP

2 AC. WATER RIGHT

TAX LOT 400
2N 48 29A

IN
THE NW 1/4, NE 1/4
SECTION 29
T 2N, R 48 E, WM

THIS TRANSFER IS
FOR A 2.0 ACRE PORTION
OF A 4.0 ACRE WATER RIGHT,
CERT 9380, PROOF #108

IMNAHA RIVER


1.0 AC

1.0 AC

OLMSTEAD DITCH

FORMER DIVERSION POINT
FOR OLMSTEAD DITCH.
PROOF #108 CERT #9380, 1904
IN SW 1/4, NE 1/4, SEC 29

THIS MAP IS BASED ON
THE WALLOWA COUNTY
ASSESSOR MAP AND IS PREPARED
FOR WATER RIGHT PURPOSES ONLY.
IT SHOULD NOT BE USED FOR PROPERTY
LOCATION PURPOSES.

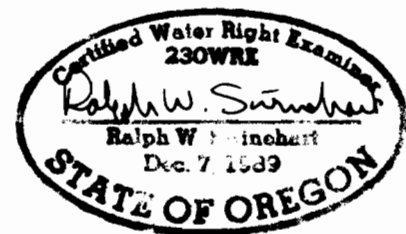

**FINAL PROOF SURVEY
CHANGE IN POINT OF DIVERSION**

T-6923

IN SECTION 29, T2N, R48E, WM WALLOWA COUNTY

FOR: ROBERT M. ZOLLMAN

DATE
8-97

JOB

DESIGN
RWS

DRAWN
TCB

WALLOWA MOUNTAIN
ENGINEERING

PO BOX 266
ENTERPRISE, OREGON 97828
426-4086

REVISIONS

SHEET
1 OF
1