


R-601
8689

T. 38 S. R. 16 E. W. M.

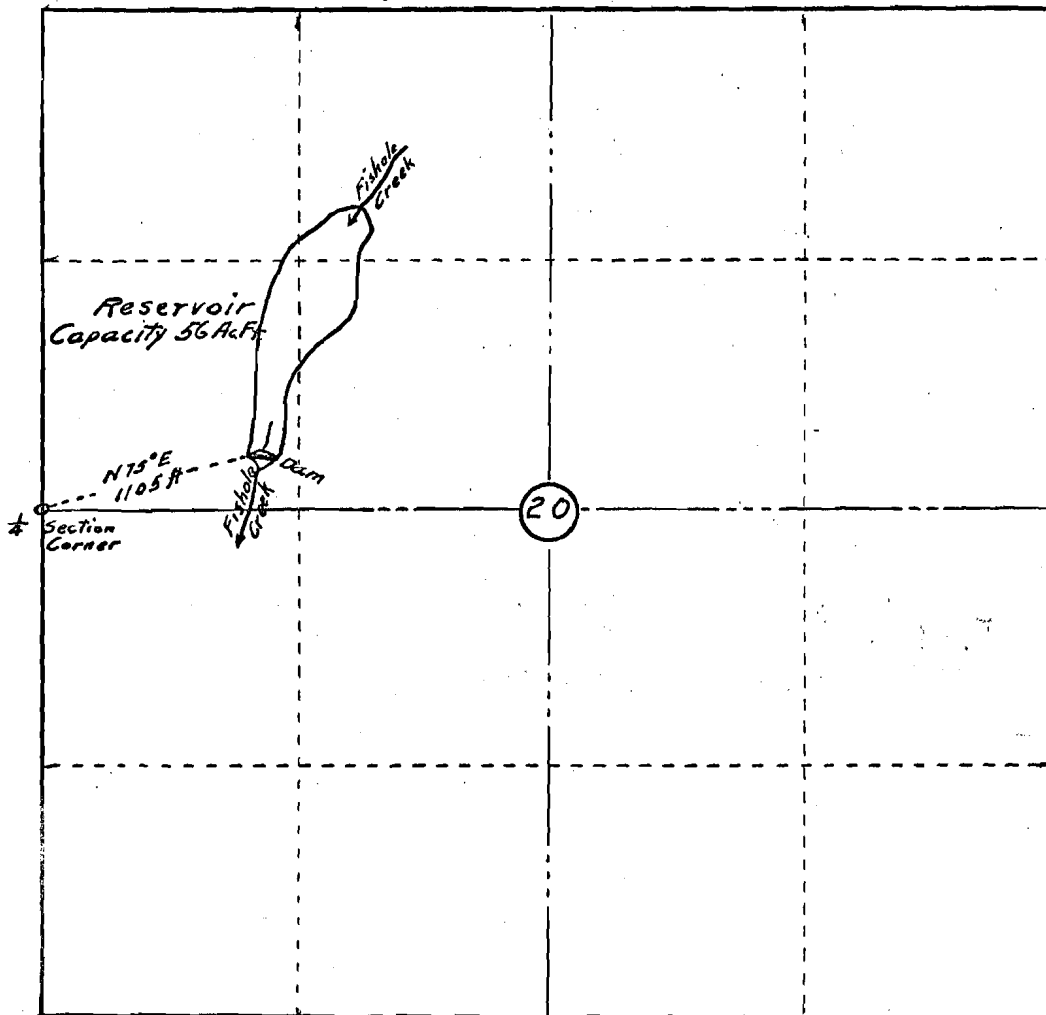

MAP

To accompany Reservoir Application
of
Gilbert C. Lapham

I, S. A. Mushen, of Lakeview, Oregon, do hereby certify that this map was made from notes taken during an actual survey made by me on November 8, 1926, and that it correctly represents the works described in the accompanying application, together with the location of streams and other ditches in the immediate vicinity.

S. A. Mushen
Registered Professional Engr.
Oregon No. 250
Date of Registration
Dec. 31, 1919.

S. A. Mushen

Application No. R 11298 P. R 601

11718

Shish Nide Ck & Mac. (2A)