


DUNHAM IRRIGATION DITCH

SCALE 1 INCH = 40 CHAINS

I, F. A. Rice, of Prineville Oregon, do hereby certify that this map was made from notes taken during an actual survey made under my immediate supervision on September 21st. 1910, and that it correctly represents the works in the accompanying application, together with the location of streams and other ditches in the immediate vicinity, and has written thereon the area in each smallest legal subdivision which it is proposed to irrigate

Fred A. Rice
Surveyor

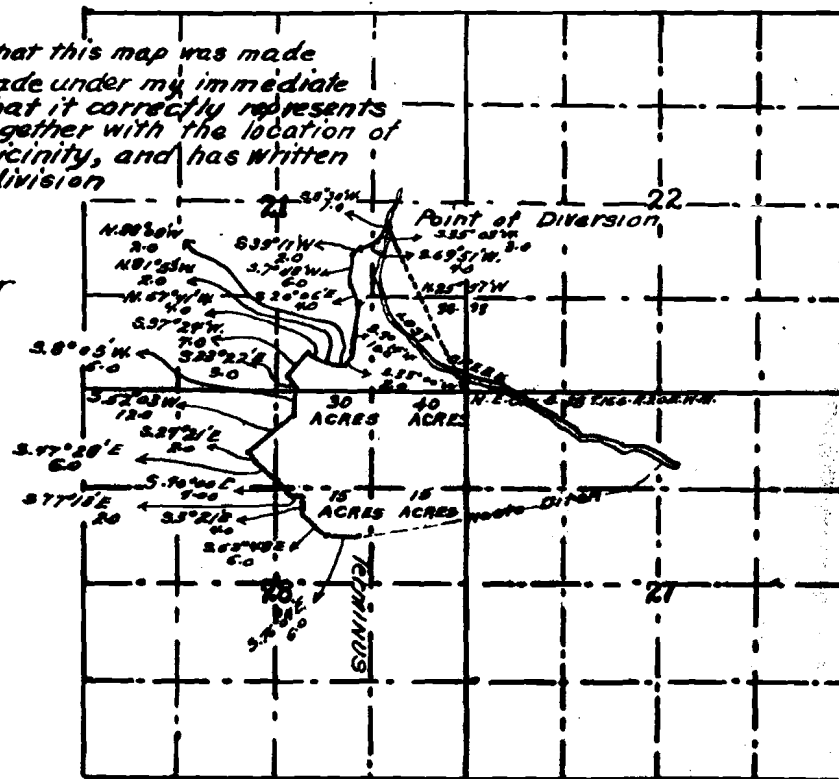

T. 16 S. R. 20 E. W. 11.

APPLICATION 1011
Permit 479

C 869