Township 28, Range [illegible].

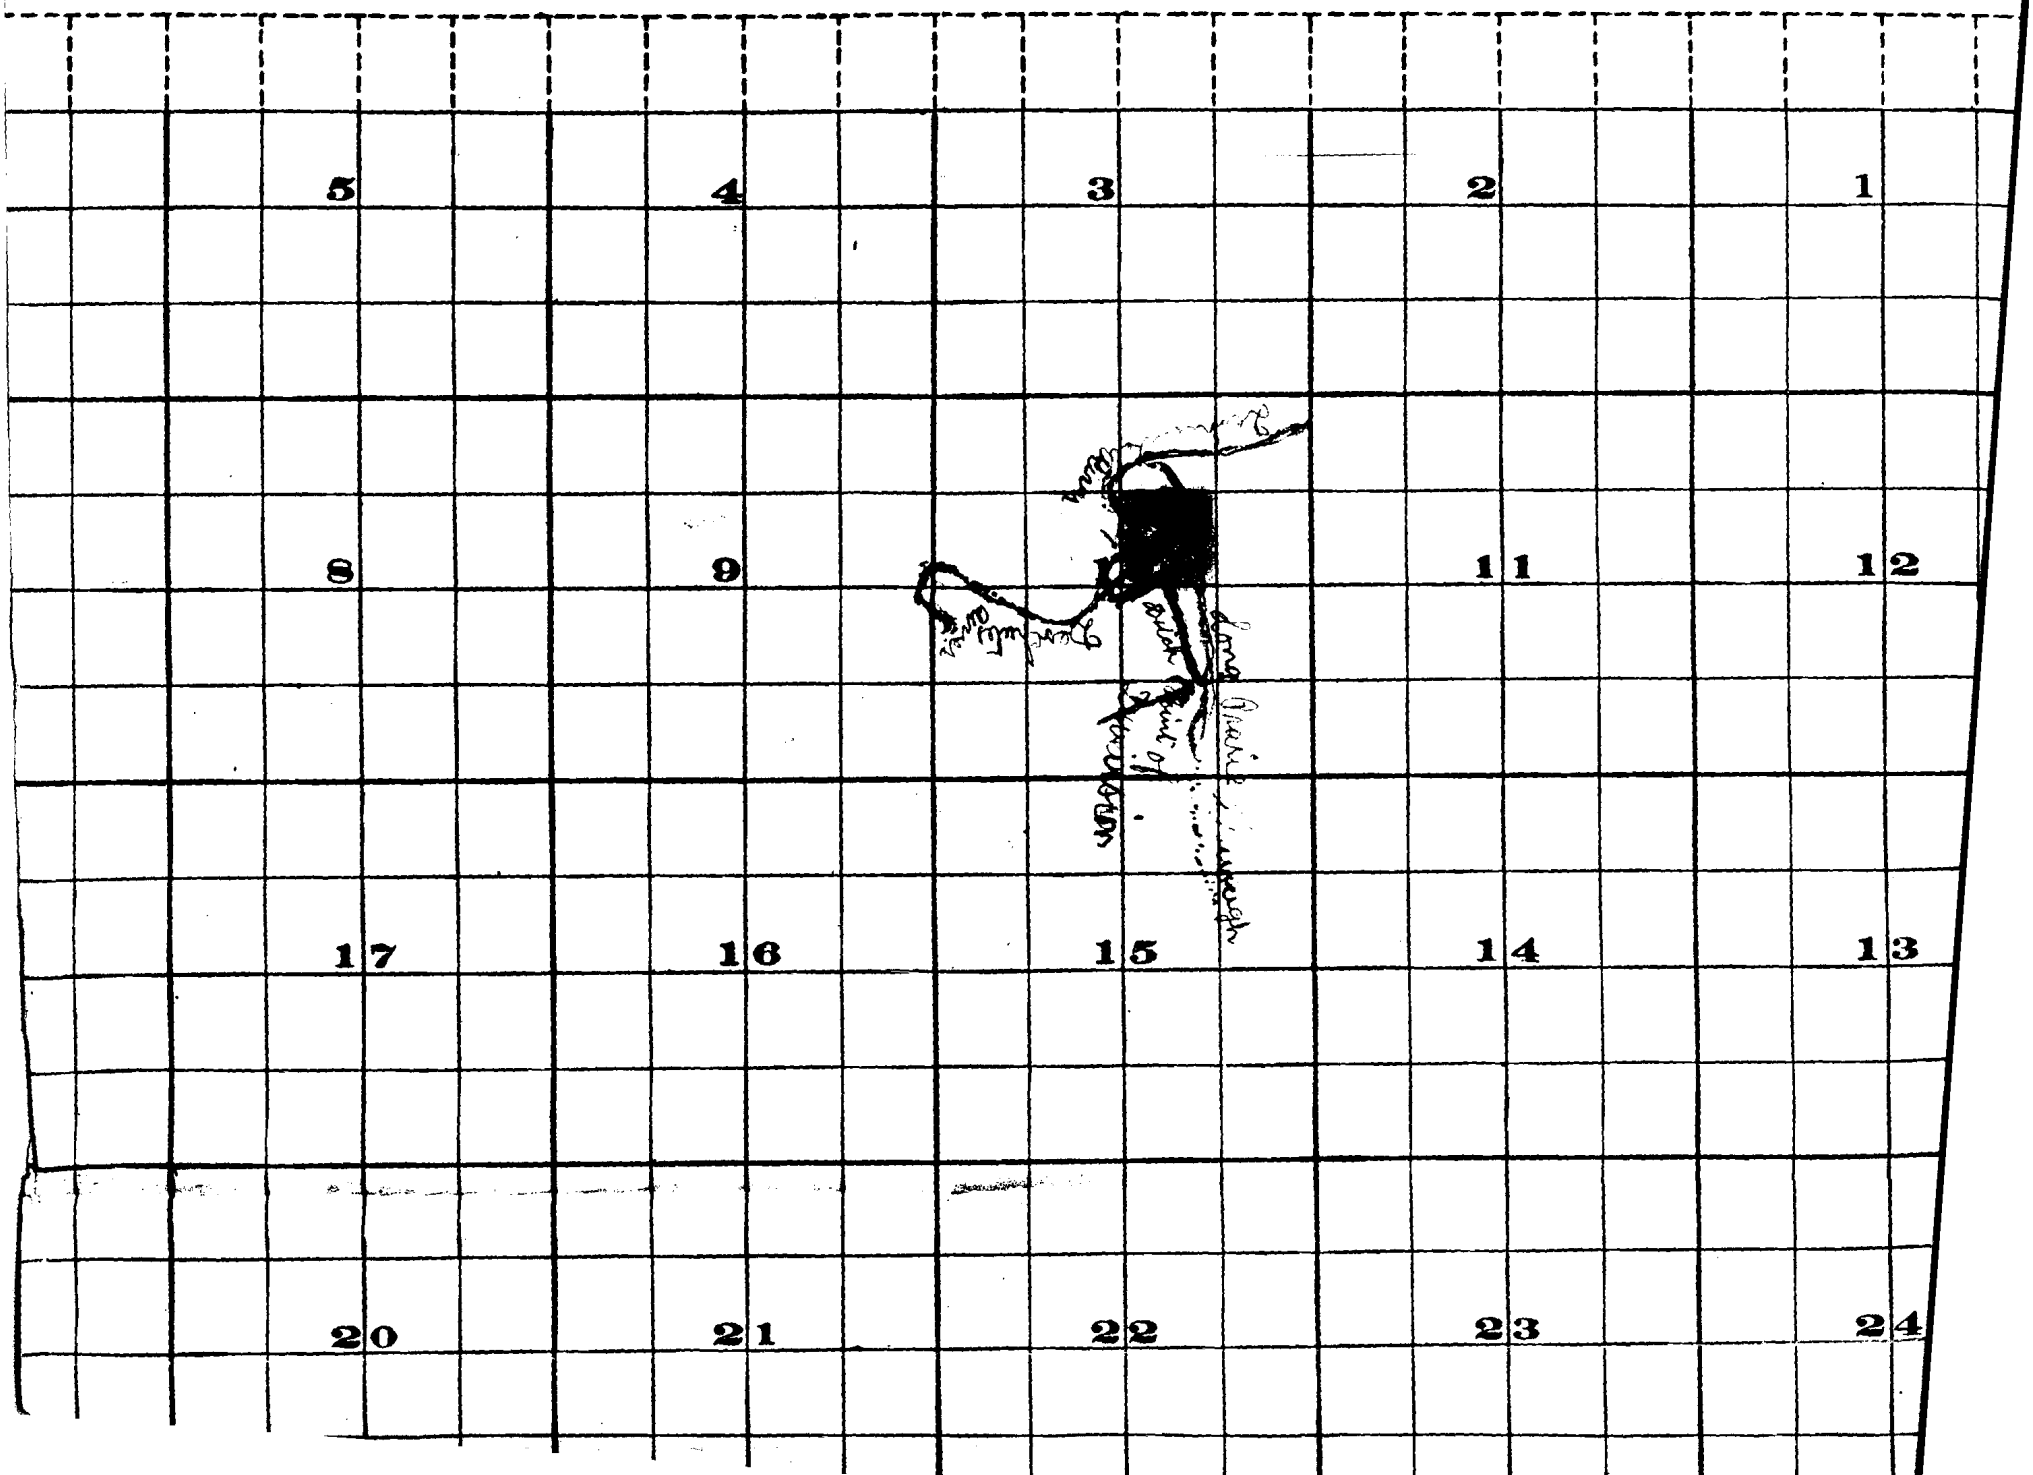

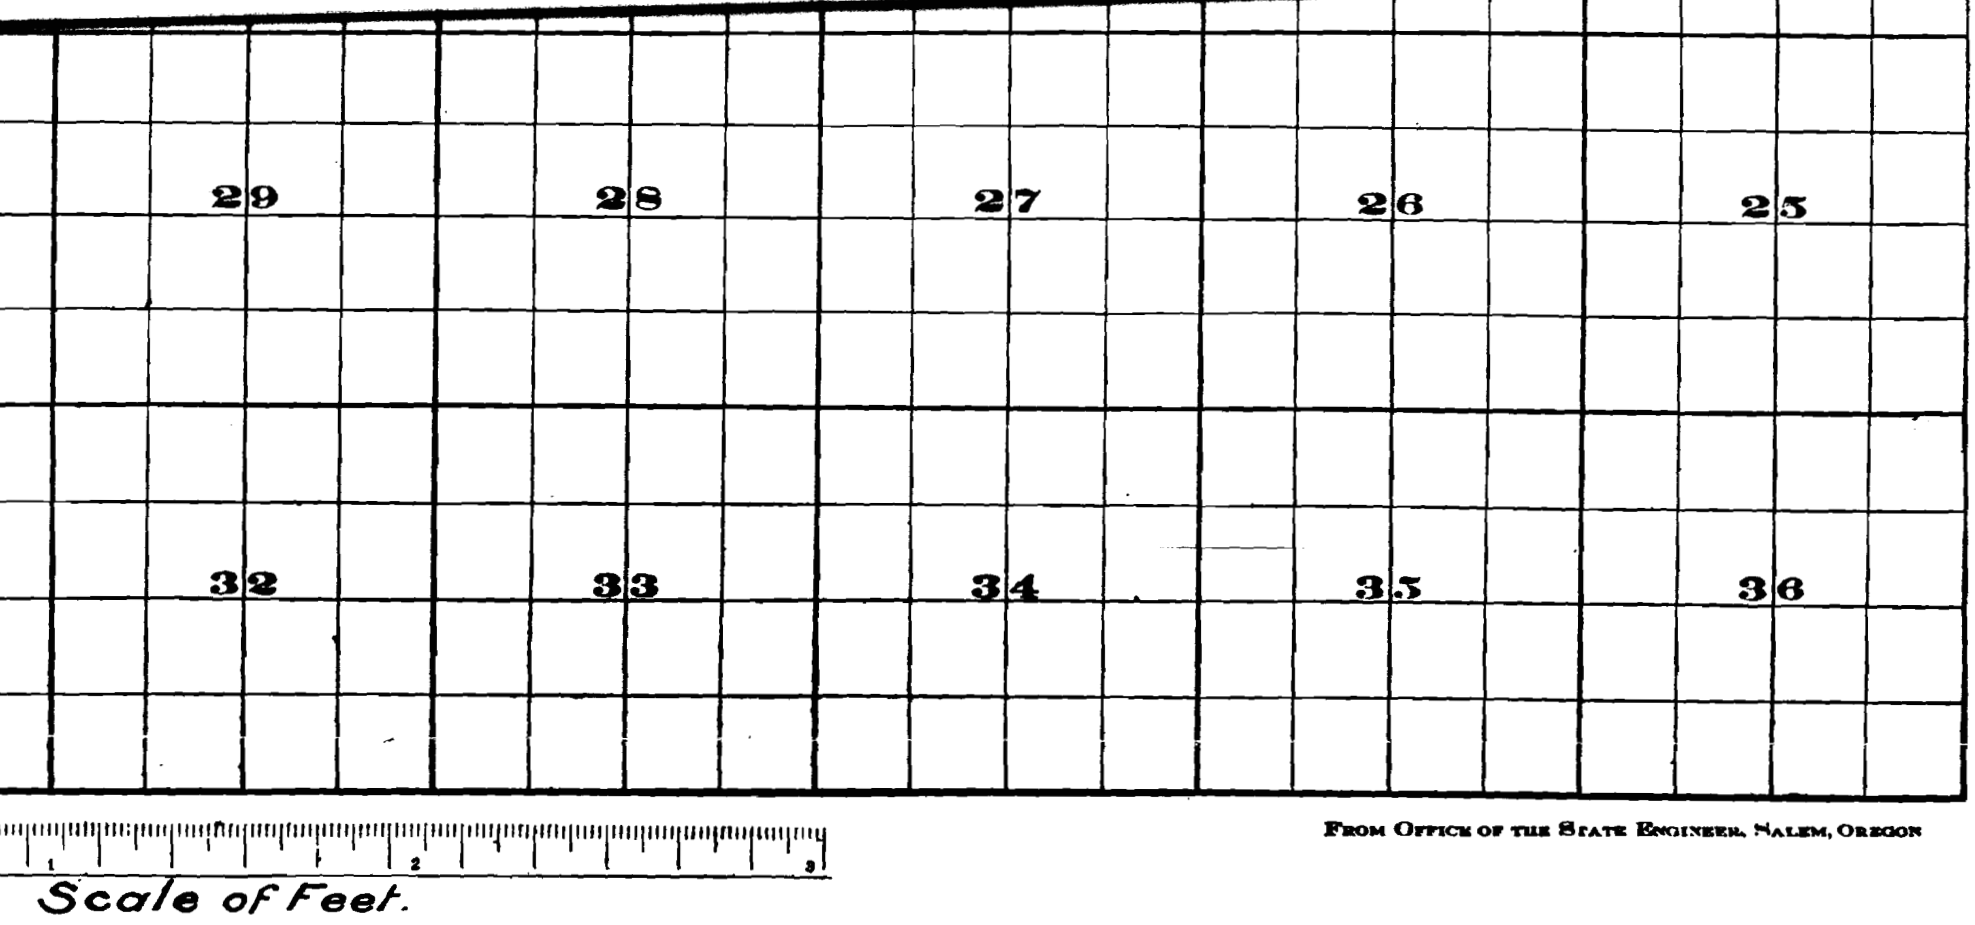

FROM OFFICE OF THE STATE ENGINEER, SALEM, OREGON

[illegible]

[illegible]

[illegible]

[illegible]

8695
9101
12300
518

4343
Application No.
Permit No.
2611