


T.39S., R.2W., W.M.
 TAX LOT No. T.39S., R.2W., SECTION 28 - 301

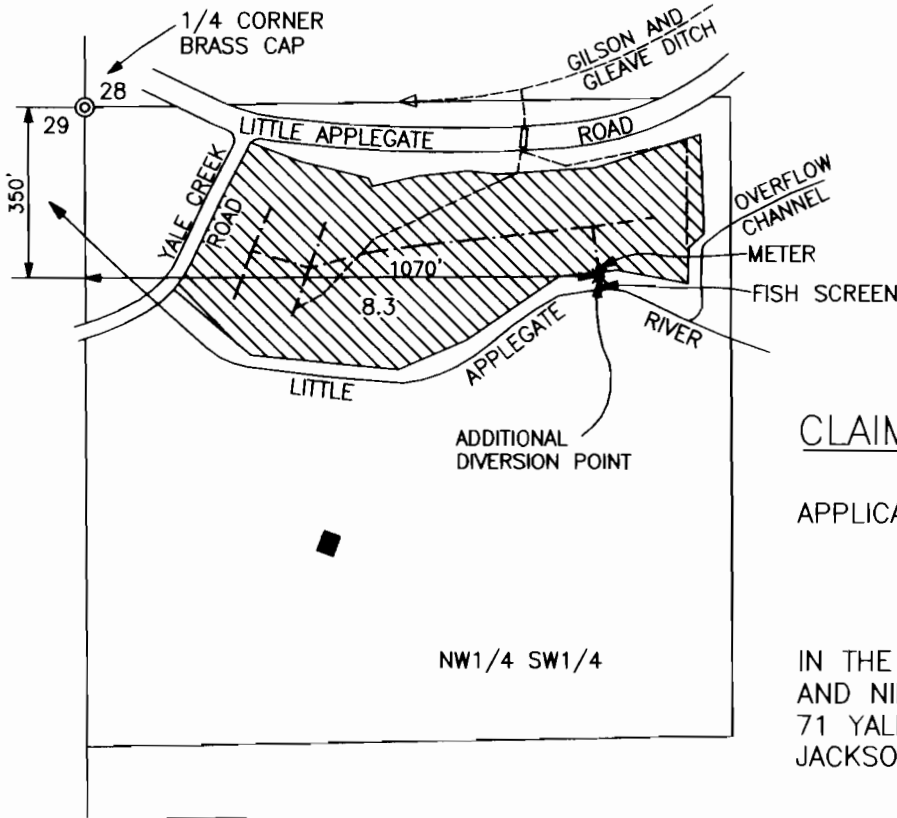

SCALE 1" = 400'

NOTE: MAP PREPARED FOR WATER RIGHT PURPOSES ONLY, NOT FOR PROPERTY BOUNDARY LOCATIONS.





CLAIM OF BENEFICIAL USE MAP

APPLICATION No. T-9070


IN THE NAMES OF WILLIAM E.
 AND NINA S. KISKADDEN
 71 YALE CREEK ROAD
 JACKSONVILLE, OR. 97530

MAP PREPARED AUGUST 31, 2006
 BY GARY D. KAISER

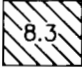 = PORTION OF CERT. 76077
 PRIORITY DATE 1872, MODIFIED
 BY T-9070, ADDITIONAL
 DIVERSION POINT

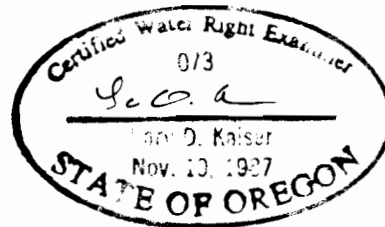

6-30-07

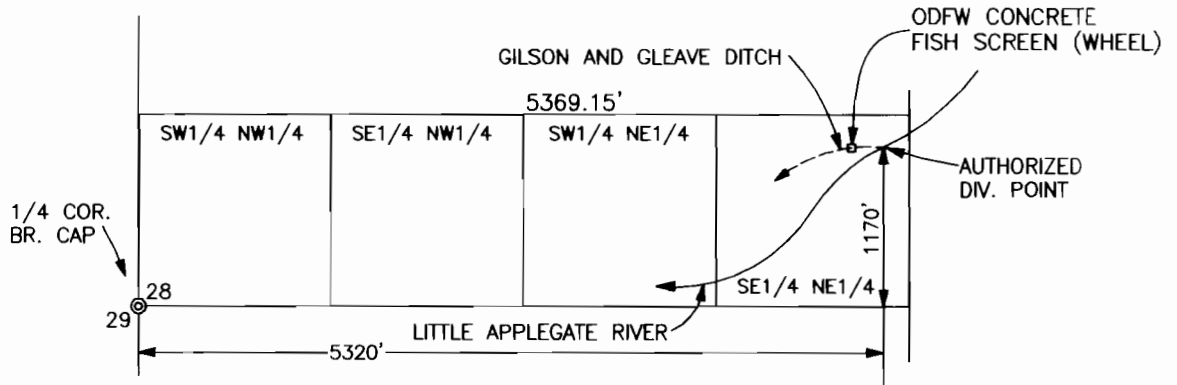

AUTHORIZED DIV. POINT
 GILSON AND GLEAVE DITCH
 SCALE: 1" = 1320'