


T. 8 S., R. ~~45~~ E., W.M.

46

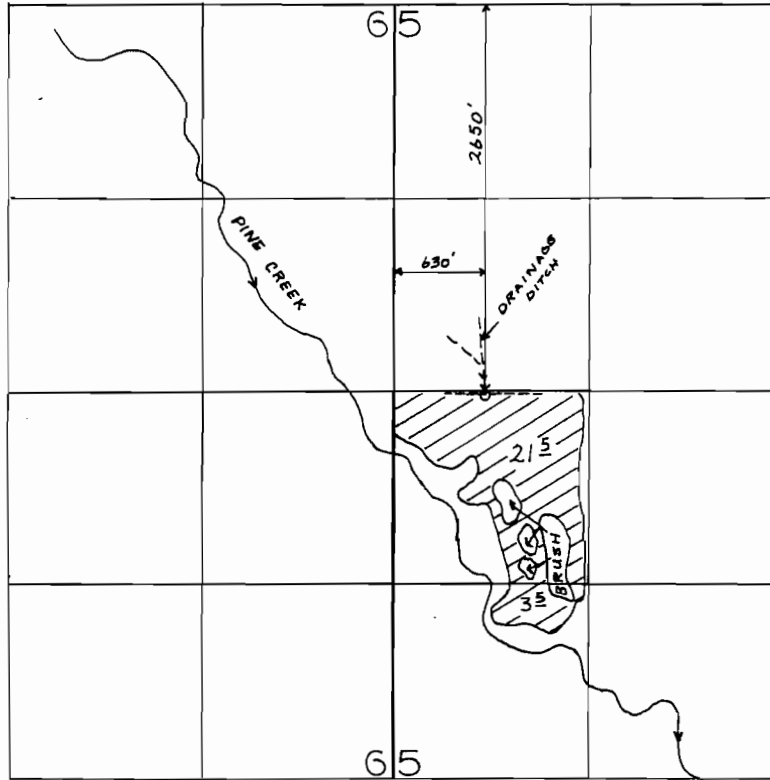

1"=1320'

# FINAL PROOF SURVEY

UNDER

Application No. 56590 Permit No. 42656

IN NAME OF

DERRAL J. AND VIVIAN L. THOMAS

Surveyed 9-17, 1993, by J. MILLER