


T 36S. R 5W., W.M.

4/20/2010
NOV 24 2010
11:11 AM

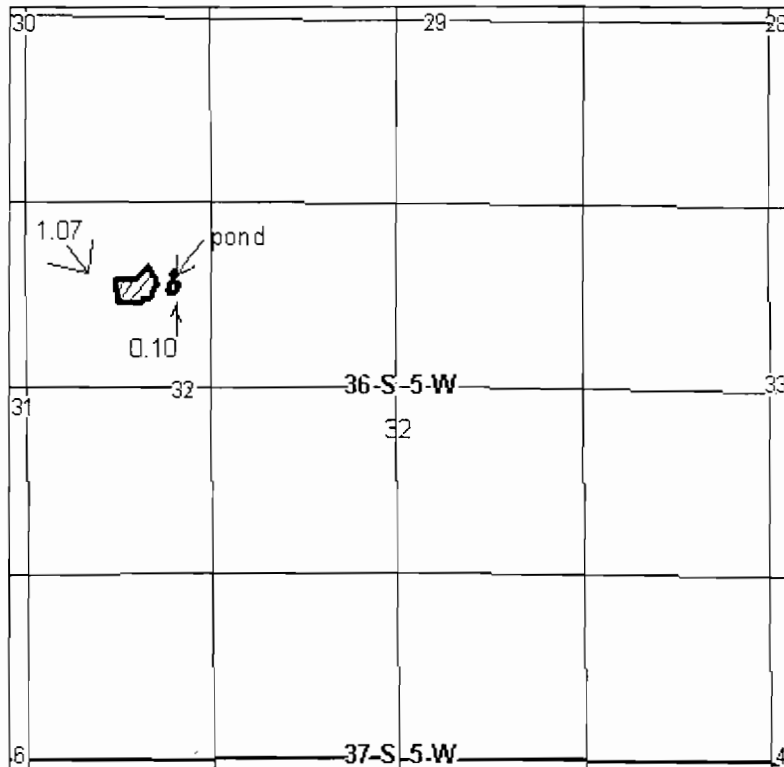

The pond is located
1053 ft. east and
1812 feet south
from the northwest corner
of T36S. R5W, Sec. 32

1 inch = 1,320 feet

FINAL PROOF SURVEY

UNDER

Application No. S51309 Permit No. 38740

IN NAME OF

CARTER S. BOEHM

Surveyed July 29, 1997, by B. Sue James Pettersen