


T37S. R6W. Sec 14

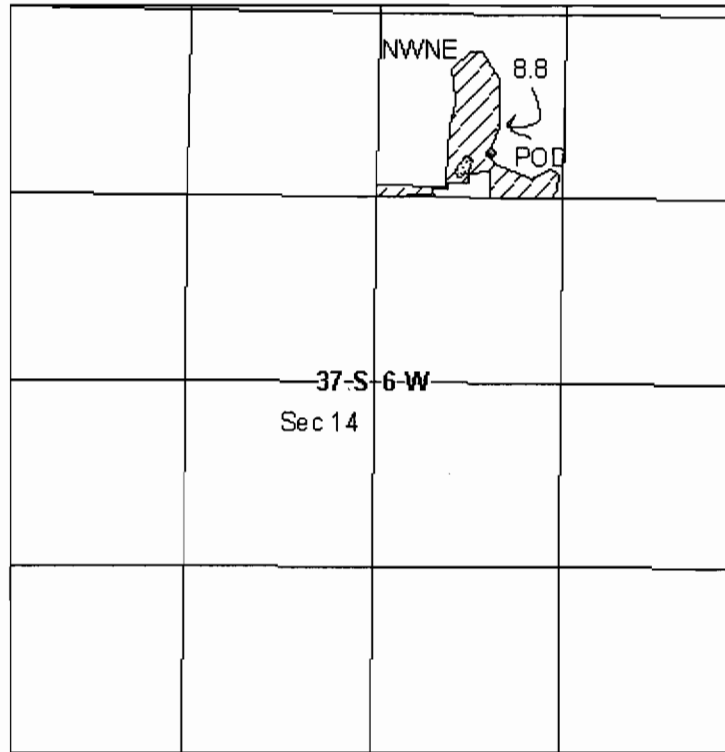

POD is 989 ft south
and 1848 ft west
from NE corner of
T37S R6W Sec 14

1 inch = 1,320 feet

Final Proof Survey

UNDER

Application No. 59936 Permit No. 45060

IN NAME OF

HERMAN E. BAERTSCHIGER SR.