


T38S R5W Section 26

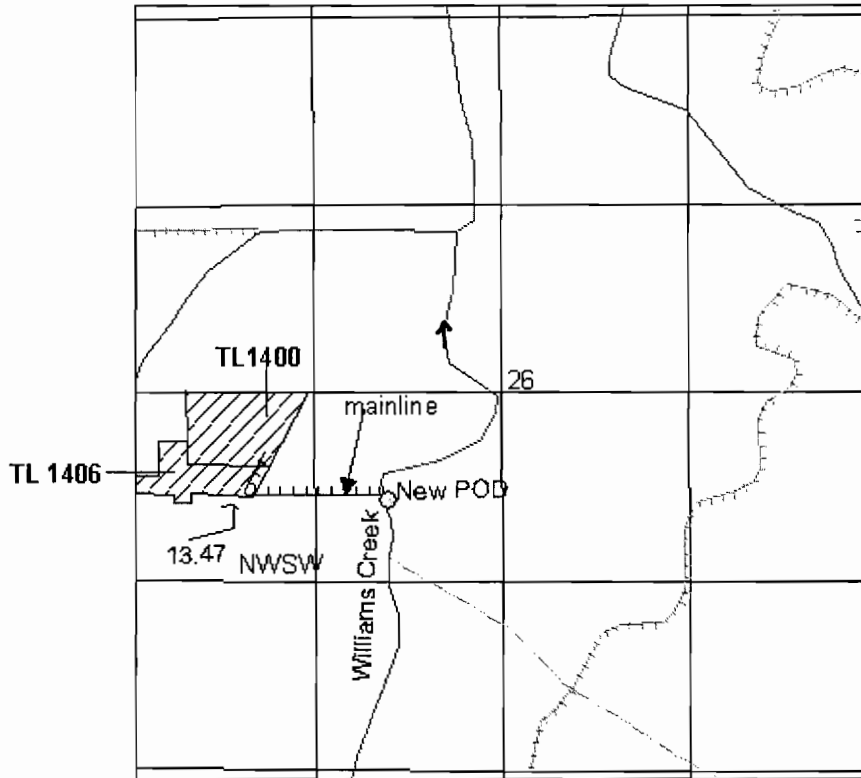

RECEIVED

DEC 22 2010

WATER RESOURCES DEPT
SALEM, OREGON

1 inch = 1,320 feet

Final Proof Survey

UNDER

Permit E-188...Transfer 5336

New POD is located 763 ft south
and 1838 ft east from the west
central corner.

Applicant: William R. Eicher

K Smith Dec. 15, 2010