

# FINAL PROOF SURVEY WATER RIGHT TRANSFER

(CHANGE IN POINT OF DIVERSION)

UNDER CERTIFICATES 45764 & 12312  
TRANSFER No. T - 7563

T. 40 S. R.08 W.  
SECTION 2

SURVEYED MARCH 17, 1998

PREPARED BY:  
JONATHAN C. SPERO C.W.R.E. 123  
1002 KINCAID RD./P.O. BOX 16  
WILLIAMS, OREGON 97544  
PH. (541) 846-6845


IN NAME OF:  
**STEVEN & MARYANNE MCMAHAN**

THIS MAP IS FOR THE PURPOSE OF  
IDENTIFYING THE LOCATION OF THE  
WATER RIGHT ONLY, AND IS NOT IN-  
TENDED TO PROVIDE LEGAL DIMEN-  
SIONS OR LOCATIONS OF PROPERTY  
OWNERSHIP LINES.

27

EAST FORK OF  
ILLINOIS RIVER

SCALE: 1" = 400'

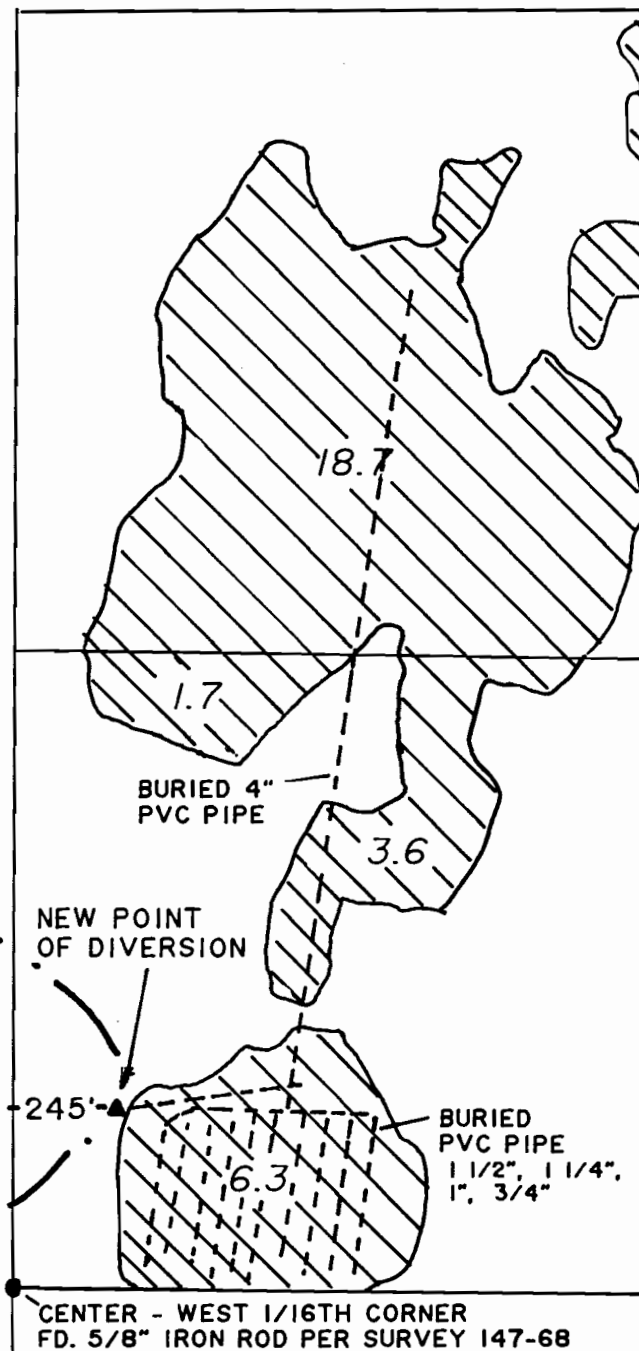


NE 1/4, NW 1/4 SEC. 2  
20.0 ACRES TRACT No. 2  
CERTIFICATE 45764

WATER RESOURCES DEPT.  
SALEM, OREGON

APR - 2 1998

RECEIVED

SE 1/4, NW 1/4 SEC. 2  
7.0 ACRES TRACT No. 1  
CERTIFICATE 45764  
3.0 ACRES TRACT No. 2  
CERTIFICATE 45764  
1.6 ACRES UNDER  
CERTIFICATE 12312

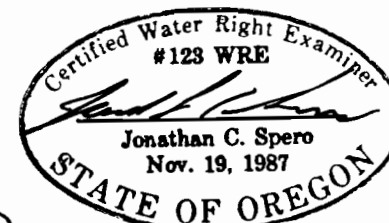

SURVEYOR'S REGISTRATION  
LICENSE RENEWAL DATE:  
JUNE 30, 1998