

FINAL PROOF SURVEY WATER RIGHT TRANSFER

(CHANGE IN POINT OF DIVERSION)

UNDER CERTIFICATES 45764 & 12312
TRANSFER No. T - 7563

T. 40 S. R.08 W.
SECTION 2

SURVEYED MARCH 17, 1998

PREPARED BY:
JONATHAN C. SPERO C.W.R.E. 123
1002 KINCAID RD./P.O. BOX 16
WILLIAMS, OREGON 97544
PH. (541) 846-6845


IN NAME OF:
STEVEN & MARYANNE MCMAHAN

THIS MAP IS FOR THE PURPOSE OF
IDENTIFYING THE LOCATION OF THE
WATER RIGHT ONLY, AND IS NOT INTENDED
TO PROVIDE LEGAL DIMENSIONS OR LOCATIONS OF PROPERTY
OWNERSHIP LINES.



EAST FORK OF
ILLINOIS RIVER

SCALE: 1" = 400'

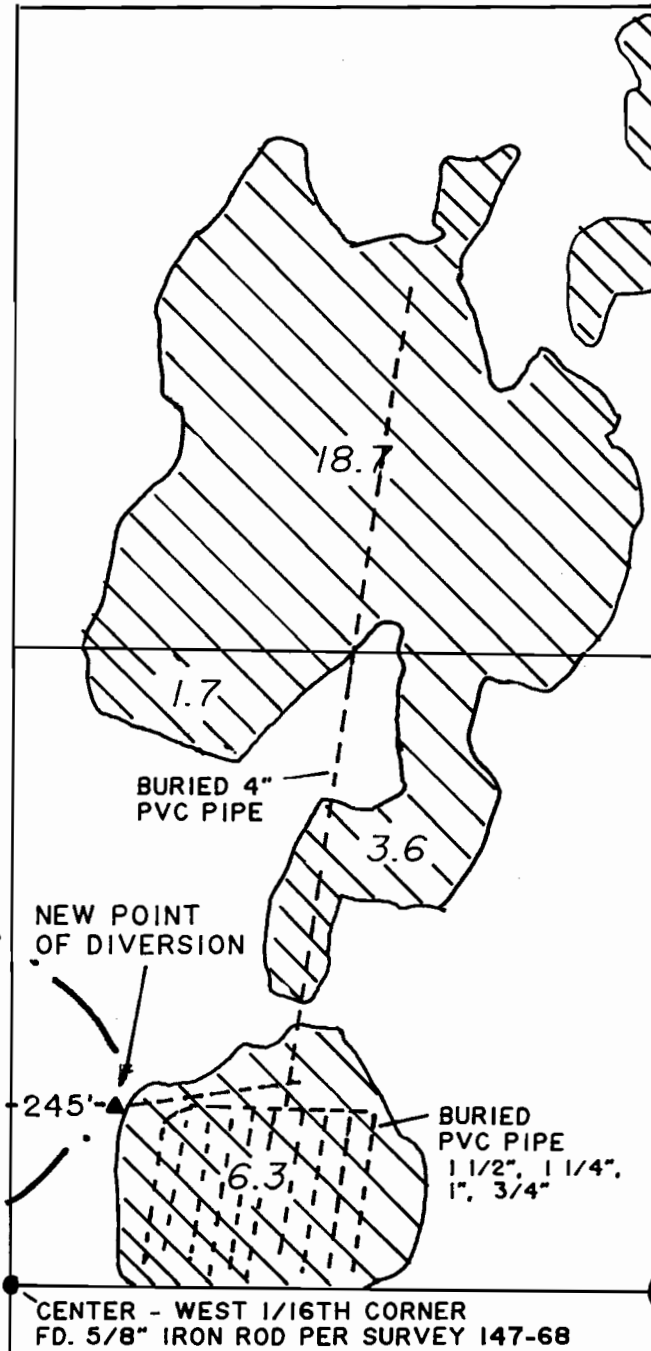

NORTH 1/4 CORNER
FOUND IRON PIPE
WITH BRASS CAP
PER JOSEPHINE
COUNTY 1991

0.5
0.8


NE 1/4, NW 1/4 SEC. 2
20.0 ACRES TRACT No. 2
CERTIFICATE 45764

WATER RESOURCES DEPT.
SALEM, OREGON

APR - 2 1998

RECEIVED

SE 1/4, NW 1/4 SEC. 2
7.0 ACRES TRACT No. 1
CERTIFICATE 45764
3.0 ACRES TRACT No. 2
CERTIFICATE 45764
1.6 ACRES UNDER
CERTIFICATE 12312

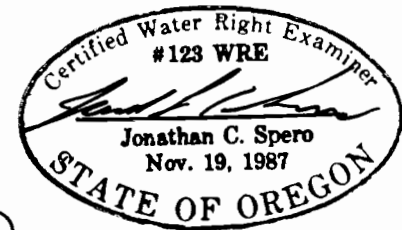

2

CENTER - WEST 1/16TH CORNER
FD. 5/8" IRON ROD PER SURVEY 147-68

SURVEYOR'S REGISTRATION
LICENSE RENEWAL DATE:
JUNE 30, 1998