


0564



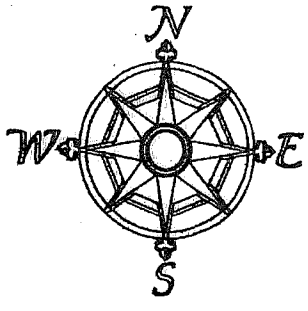


1" = 1320'

T. 37 S., R. 10 E., W.M.

**CLAIM of BENEFICIAL USE MAP
For
JESPERSEN EDGEWOOD, INC.**

Under Permit G-10952

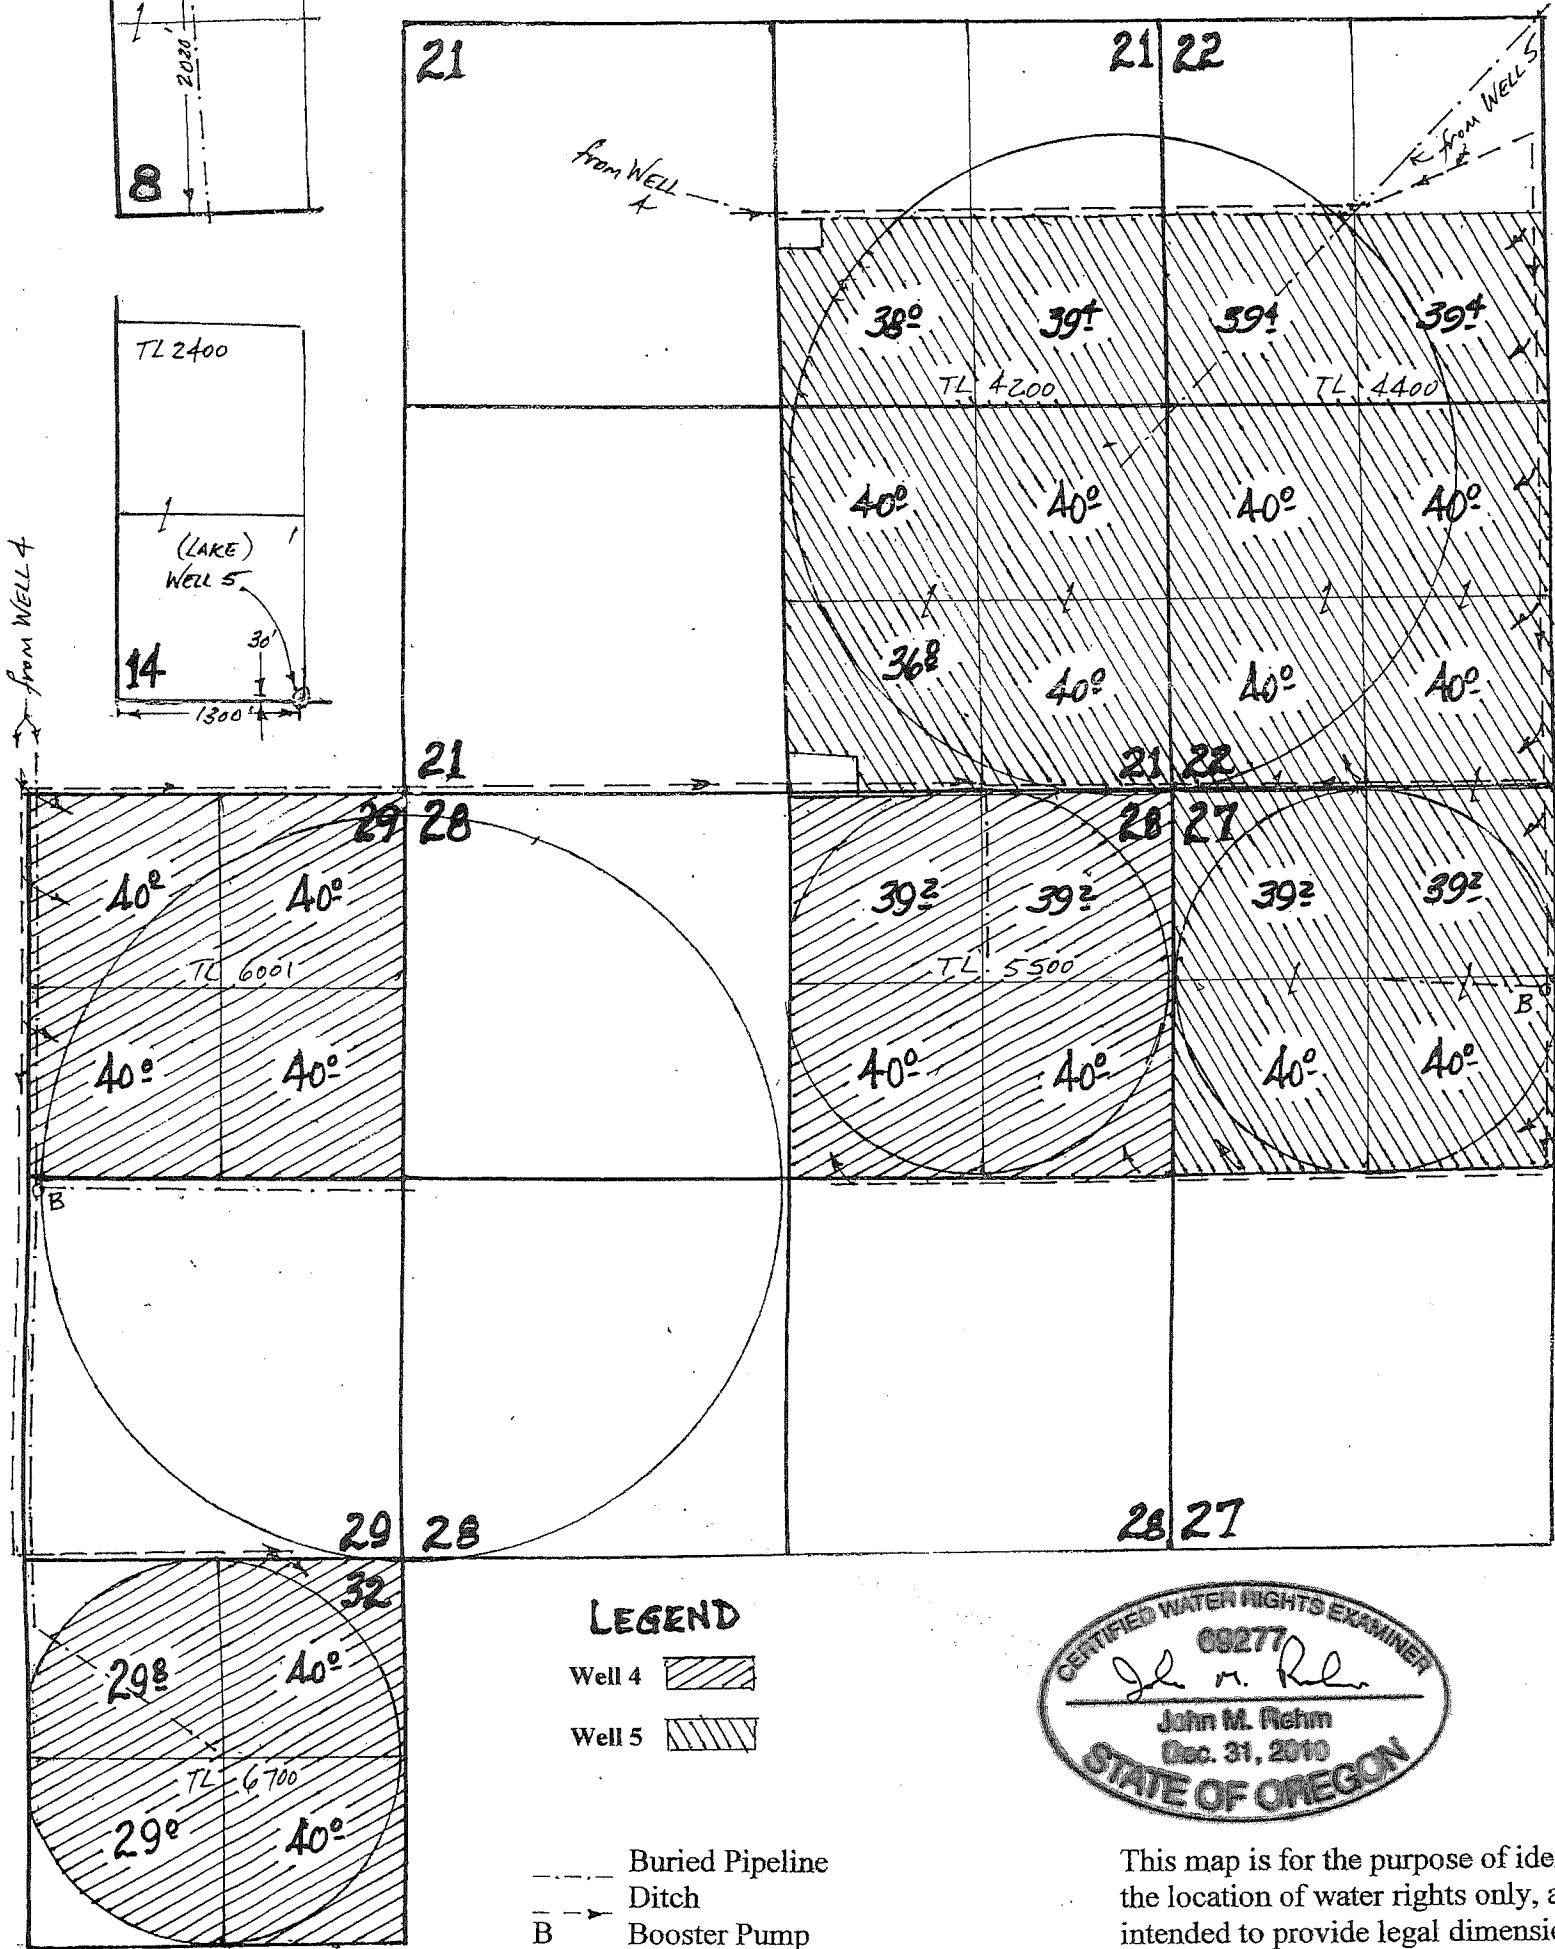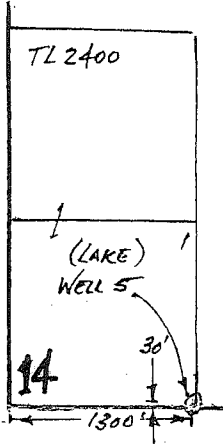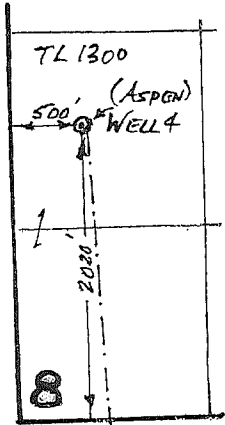


COBU MAP # 0564/1000-T

LEGEND

- Well 4
- Well 5

- Buried Pipeline
- Ditch
- Booster Pump

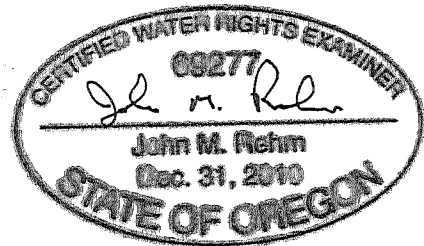

This map is for the purpose of identifying the location of water rights only, and is not intended to provide legal dimensions or locations of property lines.

RECEIVED

JAN 14 2011

WATER RESOURCES DEPT
SALEM, OREGON