


Plan of Beneficial Use Map

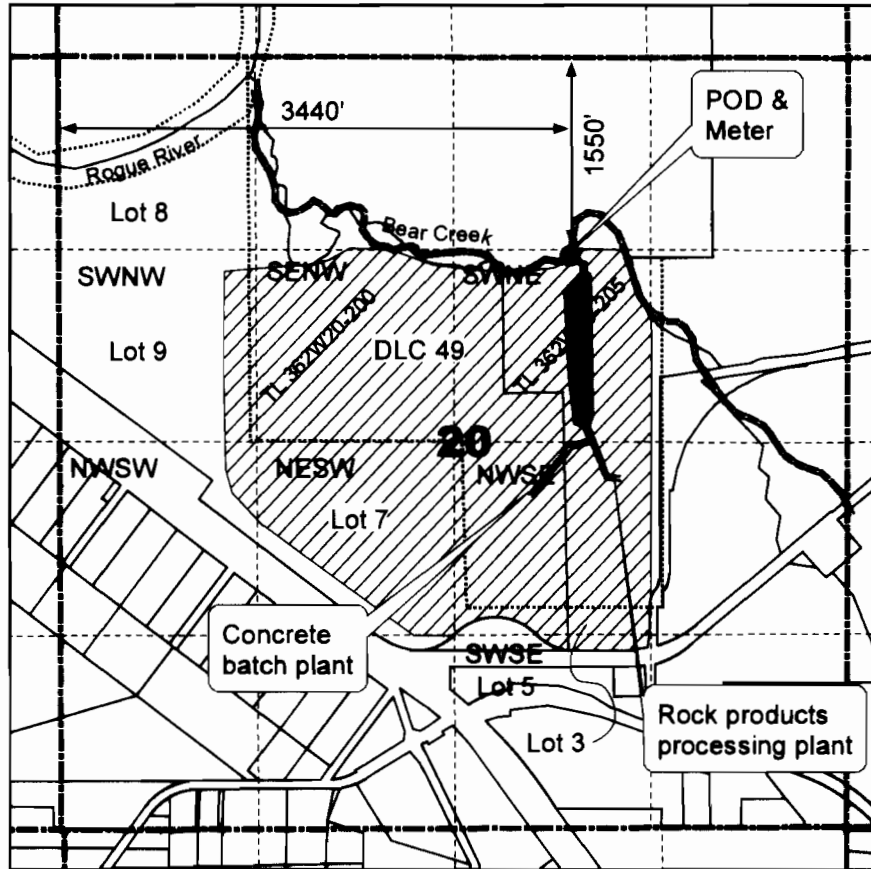





T-10250

T 36 S, R 2 W, Section 20, W.M.




0 1,320 Feet

Legend

-  Industrial Use
-  Pipeline
-  Bulge in System
-  DLC line
-  Section Line
-  Quarter-quarter line

This map is not intended to provide legal dimensions or locations of property ownership lines.

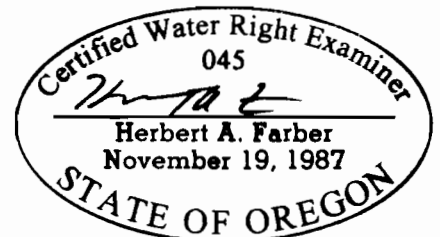

RENEWAL DATE 12-31-11