

Final Proof Survey Map

RECEIVED


Commercial Ground Water
Permit G-15785
Application G-16143
In the name of
Mallard Creek LLC

T 12 S R 1 W, W.M.

FEB 17 2011

WATER RESOURCES DEPT
SALEM, OREGON

This map is not intended to
provide legal dimensions or
locations of property ownership
lines.

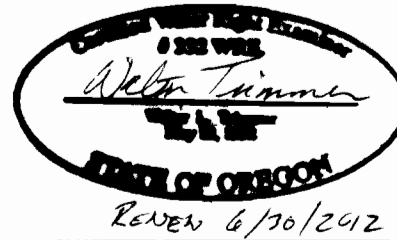

Final Proof Survey

Prepared by
Walter L. Trimmer
CWRE #332
Trimmer Engineering Inc.
3924 NW Walunt Place
Corvallis, OR 97330
541-754-2819

Scale 1" = 1320'

October 22, 2010
rev 5 Feb 2011
"meter location"

Layout: FP Map
File: MallradGWF.dwg
Based on USGS
One Horse Slough Quad

DWG 1 of 1

