


FINAL PROOF MAP T9665
 SE1/4SE1/4 SEC. 33, T.38S., R.3W., W.M.
 JACKSON COUNTY, OREGON
 FOR
 ADRIAN J. CORTEZ JR.
 5194 TRAIL CANYON DRIVE
 MIRA LOMA. CA 91572

RECEIVED
 AUG 14 2006
 WATER RESOURCES DEPT
 SALEM, OREGON



Scale: 1"=400'
 Date: May 17, 2006

T.38S., R.3W., Sec. 33

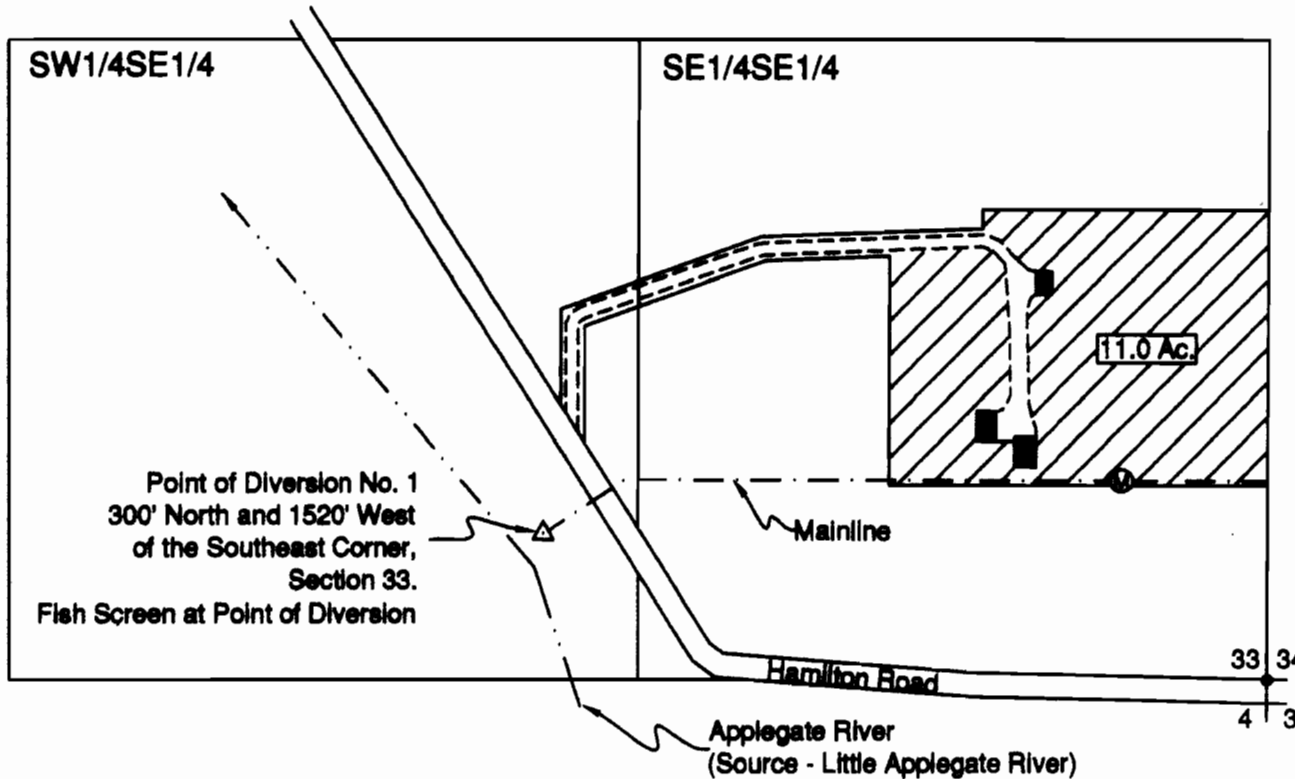

LEGEND


- Found Survey Monument
- Denotes Building
- Ⓜ Flow Meter
- ▨ Denotes area under Special Order Volume 68, Pages 11-13, Priority Date Sept. 1, 1857



HAROLD L. CENTER
 2604 David Lane
 Medford, OR. 97504
 Phone 541-535-6108
 Oregon Certificate No. 152
 Certificate Renewal Date: 12/31/2007

This map was prepared for the purpose of identifying the location of a water right only and is not intended to provide legal dimensions or location of property ownership.

T 39 S, R 3 W, W.M.

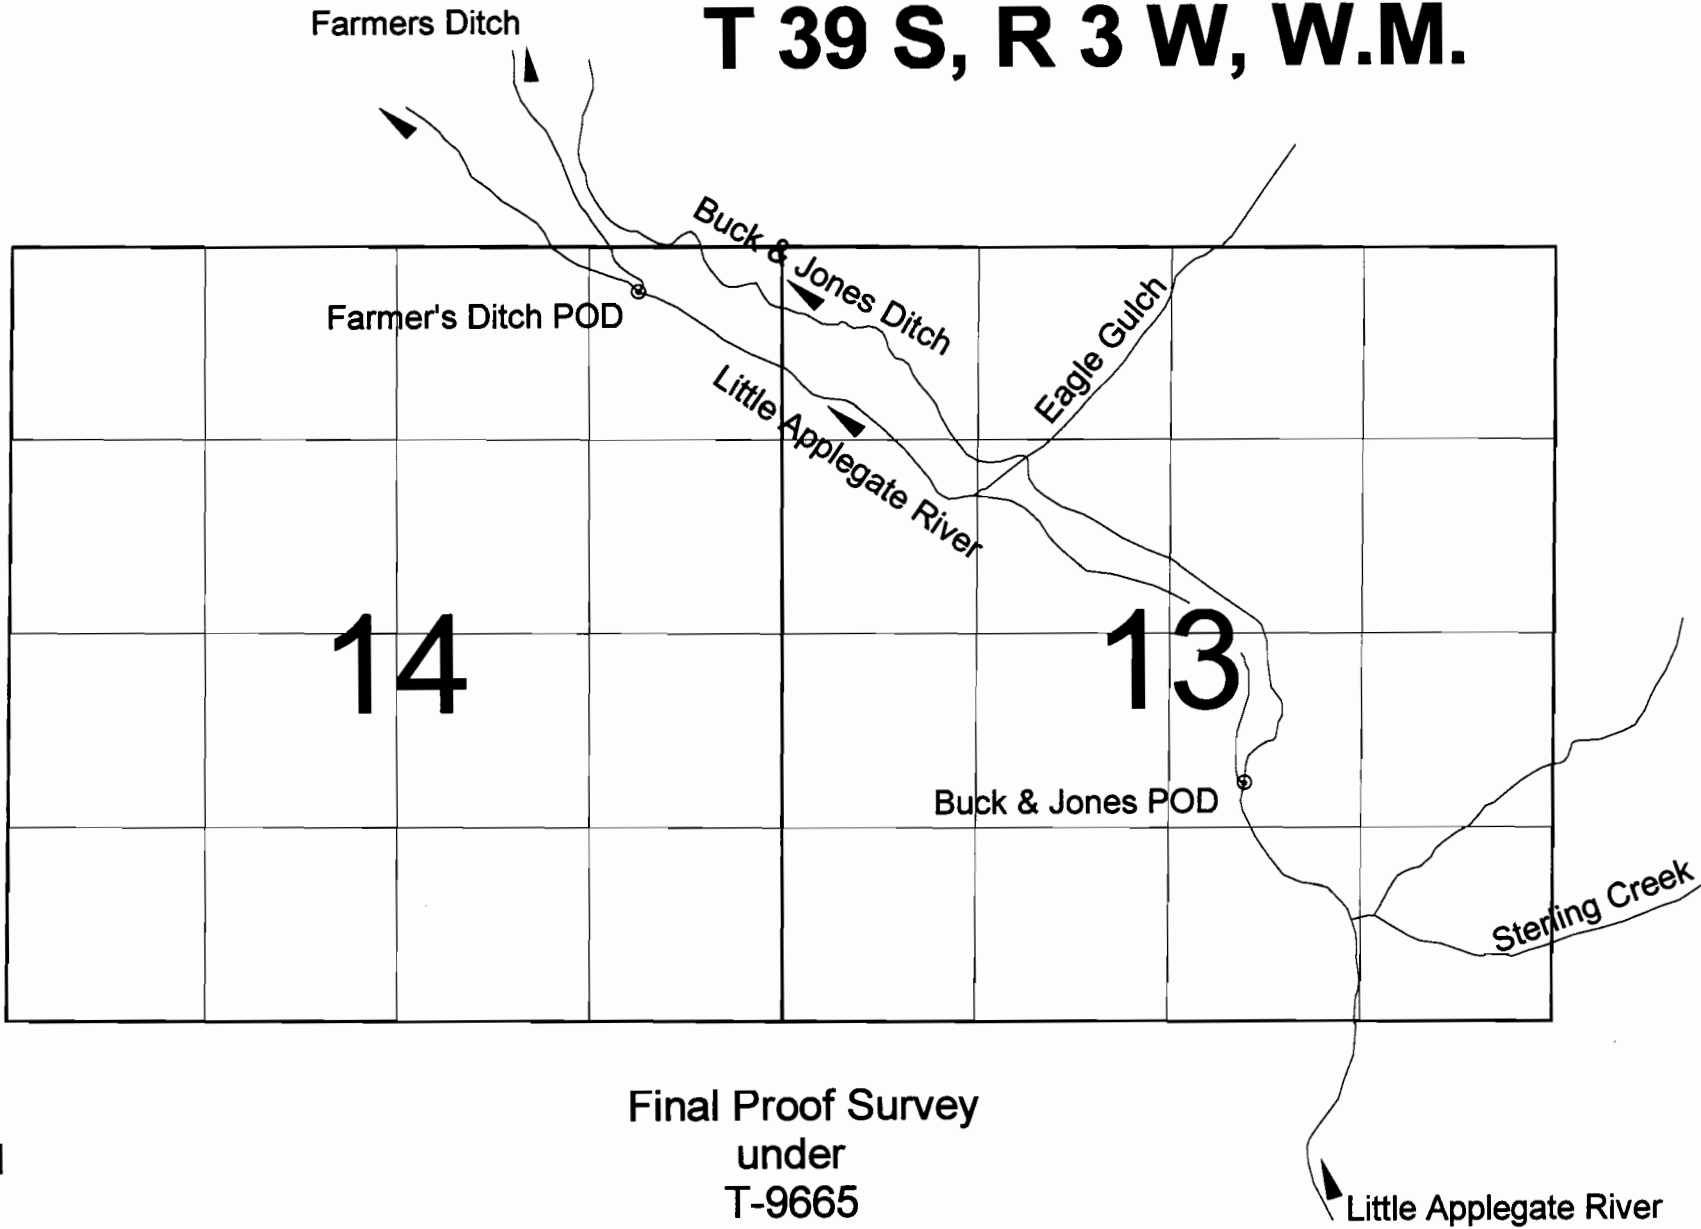

Final Proof Survey
under
T-9665

Farmer's Ditch POD - GPS coordinates: Latitude 42.18400, Longitude -123.0174
Buck & Jones Ditch POD - GPS coordinates: Latitude 42.17508, Longitude -123.0018

