


T. 1 S., R. 3 W., W. M.

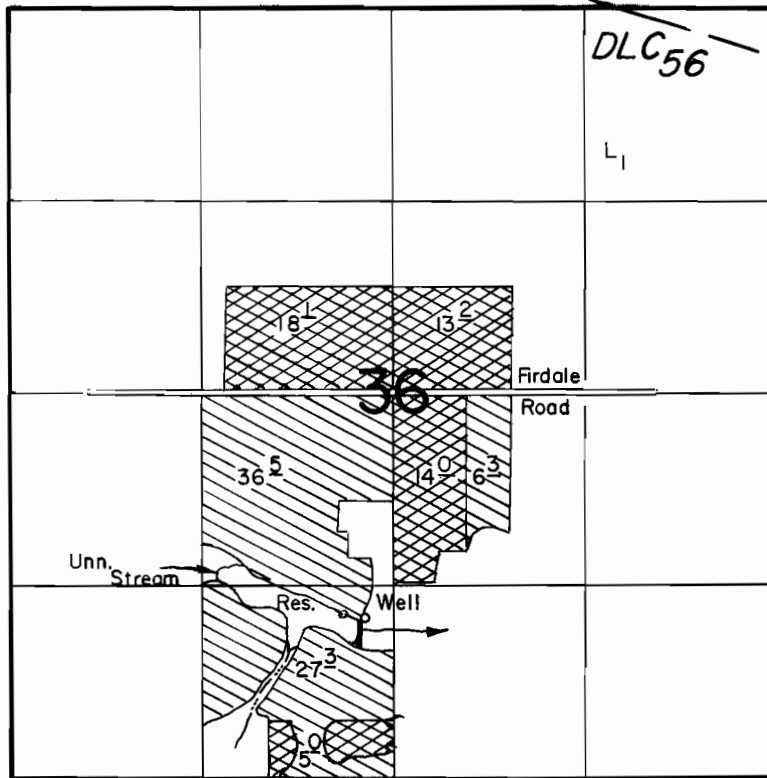

P.O.D. Loc. : 1000' N. & 240' W.
 Well Loc. : 1100' N. & 190' W., both from S. 1/4 Cor. Sec. 36.

Scale : 1" = 1320'

FINAL PROOF SURVEY

UNDER
 Transfer 5797

68724 49702

Application No. G-11523. Permit No. G-10621

IN NAME OF

RICHARD L. & SANDRA M. TWIGG, dba TWIGG FARM


Surveyed JUNE..... 1987, by Ben Bishop.....

41067-178-137 A
 1/5/07 TMW

WATER RIGHT TRANSFER MAP

SECTION 36, T1S, R3W, WM
 TL 900, 902, 1800 (TAX MAP 1S3-36)
 WASHINGTON COUNTY, OREGON
 WILLAMETTE RIVER BASIN

PREPARED FOR:
 TWIGG FARMS
 31500 SW FIRDALE ROAD
 CORNELIUS, OR 97113

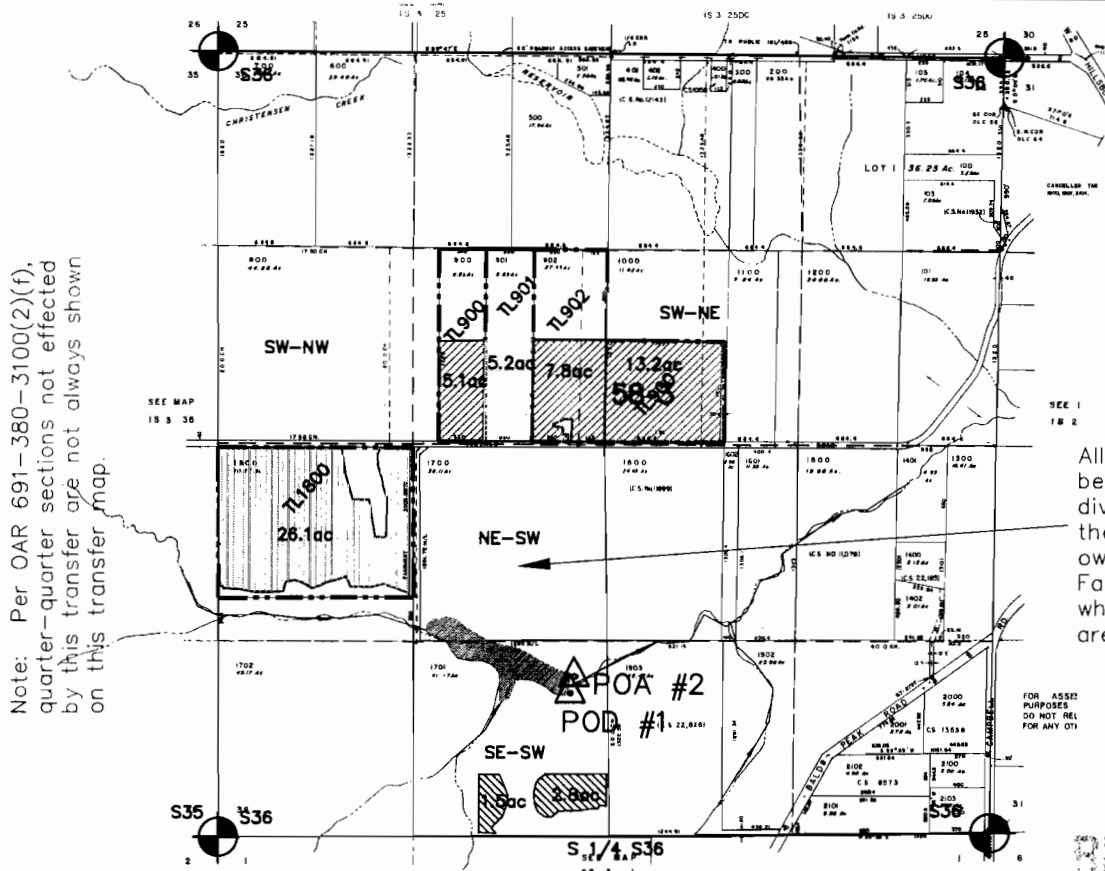


Note: Per OAR 691-380-3100(2)(f), quarter-quarter sections not effected by this transfer are not always shown on this transfer map.

All of the land between the diversions and the POU is owned by Twigg Farm and that is why the pipelines are not shown.

POD #1 (DAM) IS 1000' NORTH AND 240' WEST OF SOUTH 1/4.
 POA #2 (WELL) IS 1100' NORTH AND 190' WEST OF SOUTH 1/4.

- FROM LANDS CERT. 68504 AND 76062
- CERT 68504 LANDS UNCHANGED
- PROPOSED PLACE OF USE
- CERT 76062 LANDS UNCHANGED (REMAINING). ALSO SEE NOTE.
- POD OR POA
- SECTION CORNER
- TAXLOT BOUNDARY

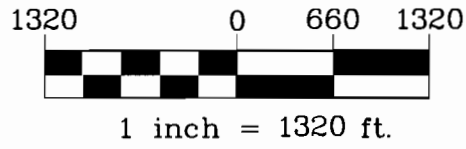

RECEIVED

DEC 27 2010

WATER RESOURCES DEPT
 SALEM, OREGON
 Certified Water Right Examiner
 #385

 Eric A. Urstadt
 May, 11 1994
 STATE OF OREGON
 EXPIRES 6/30/2012

Stuntzner
 Engineering & Forestry, LLC

MAP BASE:
 WASH COUNTY TAX MAP 1S336, 2010 GOOGLE AERIAL PHOTO, AND CERT MAPS

THIS MAP WAS PREPARED FOR THE PURPOSE OF IDENTIFYING THE LOCATION OF A WATER RIGHT ONLY AND IS NOT INTENDED TO PROVIDE LEGAL DIMENSIONS OR LOCATION OF PROPERTY OWNERSHIP LINES.

Project: 310-2-080
 Drawing: 3102080E.dwg
 By: EAU
 Checked by: EAU
 Date: 10NOV2010

T 11176