


T37S. R6W. Sec 5

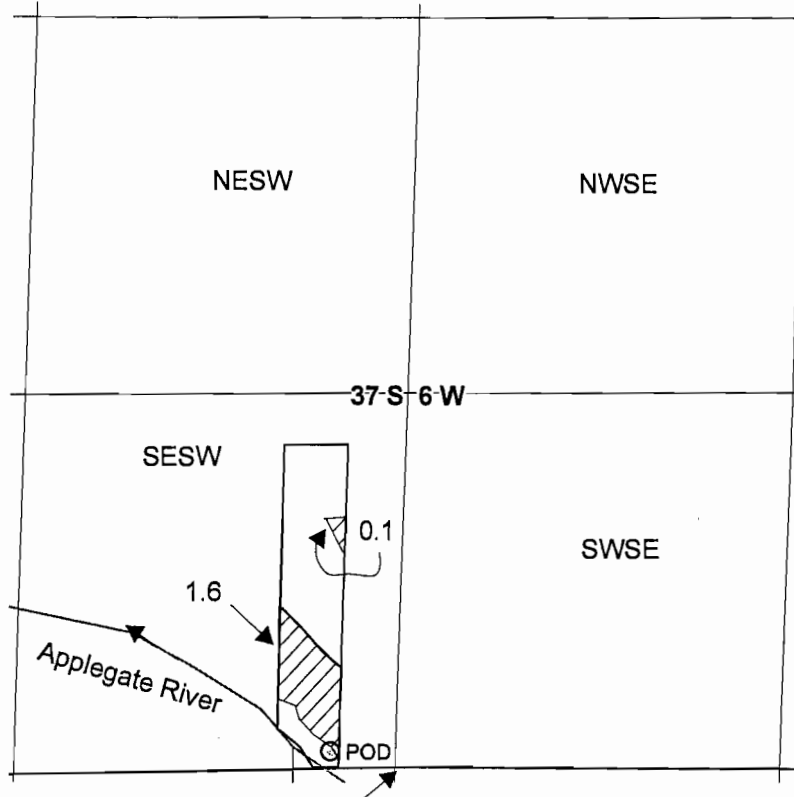

POD is 55 feet north
and 233 feet east of
south central corner.

South Central Corner

1 inch = 660 feet

RECEIVED

JAN 24 2011

WATER RESOURCES DEPT
SALEM, OREGON

FINAL PROOF SURVEY

UNDER

Application No. 68666..Permit No. 49686

IN NAME OF

Peter Gleysteen