


# T36S R7W Sec 22

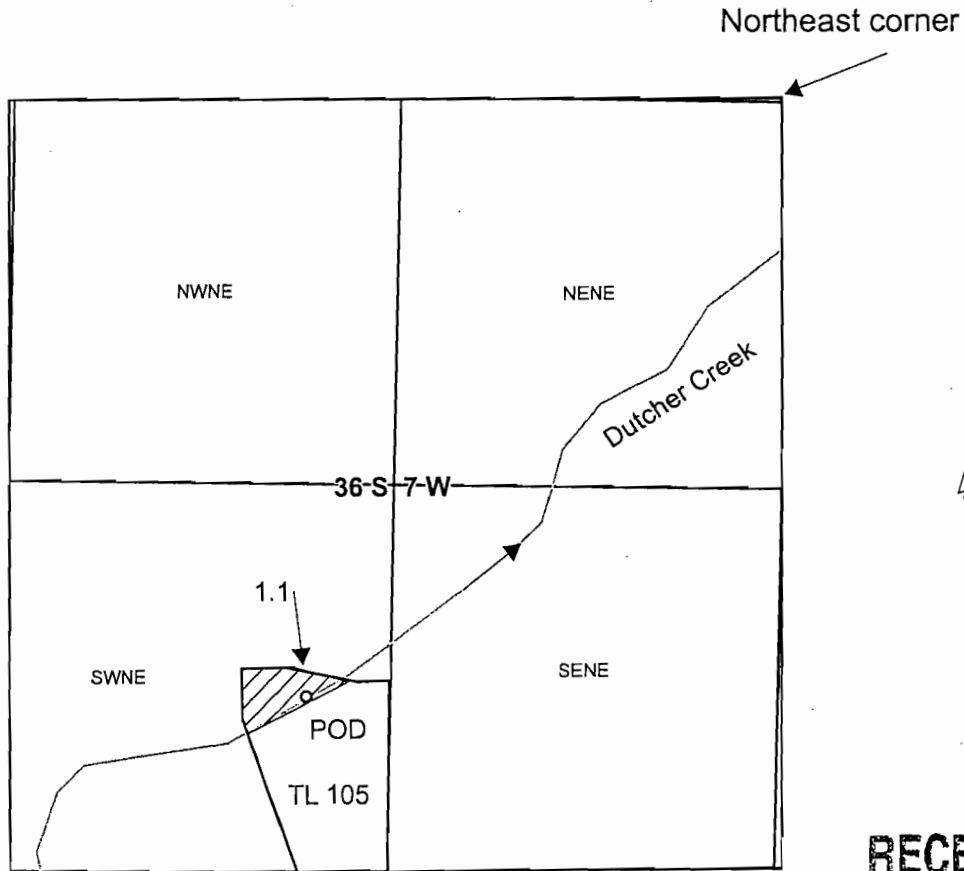

POD is located 2027 ft south  
and 1606 ft west from the  
northeast corner of Sec 22.

1 inch = 660 feet

**RECEIVED**

FEB 03 2011

WATER RESOURCES DEPT  
SALEM, OREGON

## FINAL PROOF SURVEY

UNDER


Application No. 57067 Permit No. 42948

IN NAME OF

Hollis Gunter

FSA09 K Smith January 25, 2011

# T36S R7W Sec 22

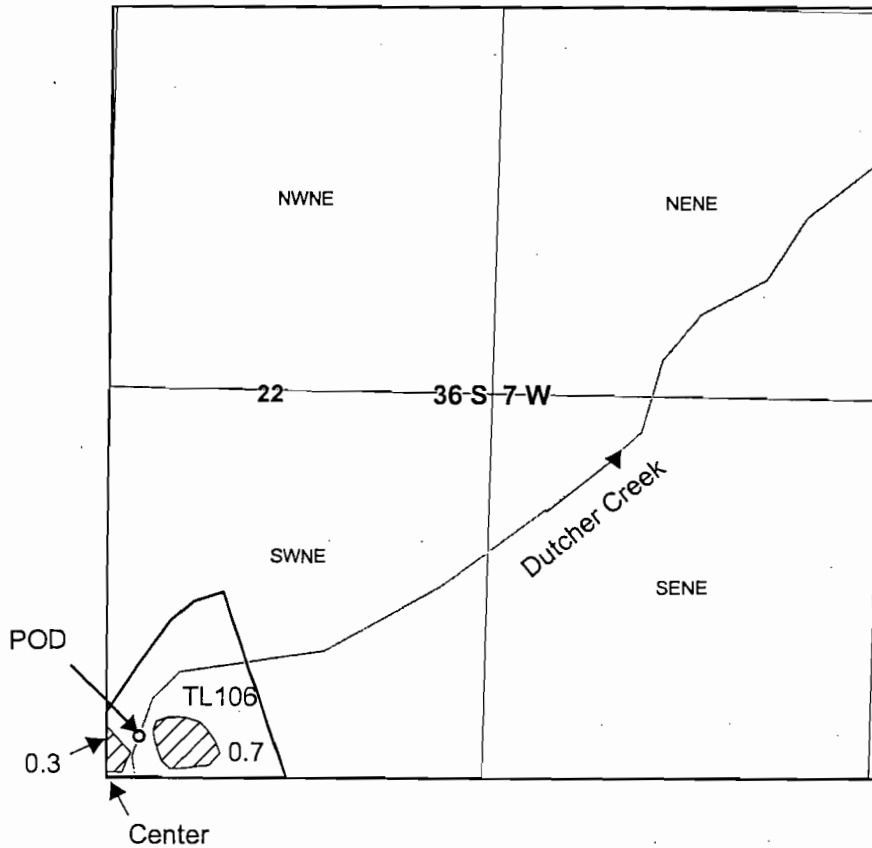

POD is 142 ft east  
and 139 feet north  
of the center of Sec. 22

1 inch = 660 feet

**RECEIVED**

FEB 03 2011

WATER RESOURCES DEPT  
SALEM, OREGON

## FINAL PROOF SURVEY

### UNDER

## Application No. 57067 Permit No. 42948

### IN NAME OF

## Rick Robertson Logging, Inc.