


T36S R7W NE 1/4 Sec 22

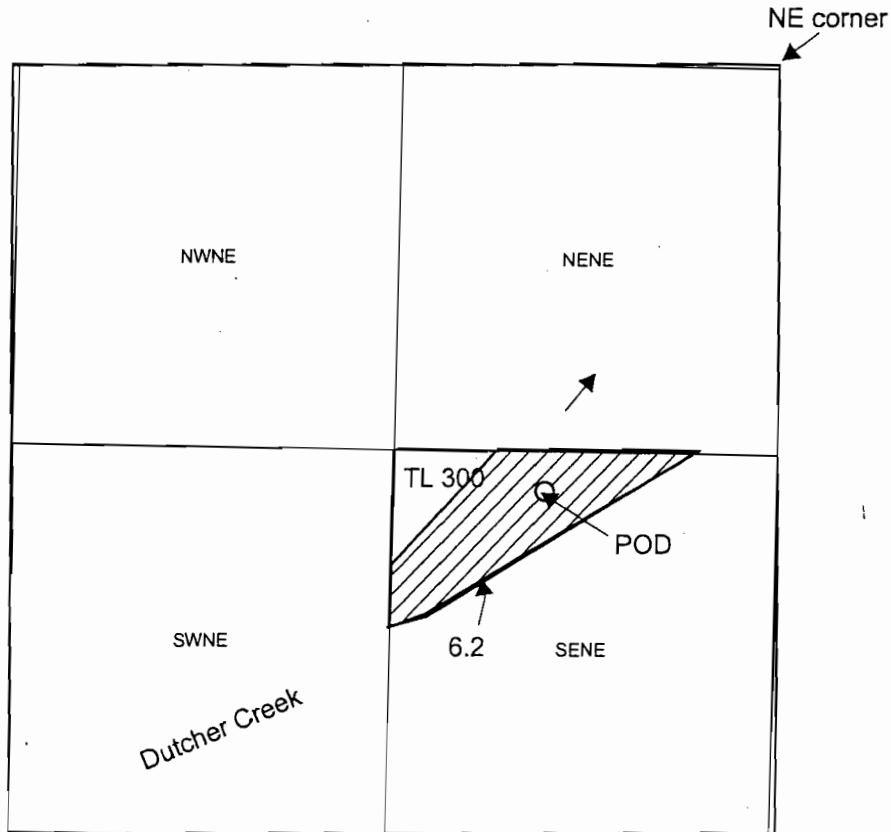

POD is 1447 ft south
and 803 ft west from
NE corner Sec 22.

1 inch = 660 feet

FINAL PROOF SURVEY UNDER

Application No. 58450 Permit 44062

IN NAME OF
Celia A. Randolph

RECEIVED

JAN 31 2011

WATER RESOURCES DEPT
SALEM, OREGON