
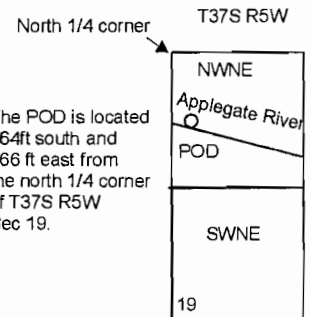


T37S R6W

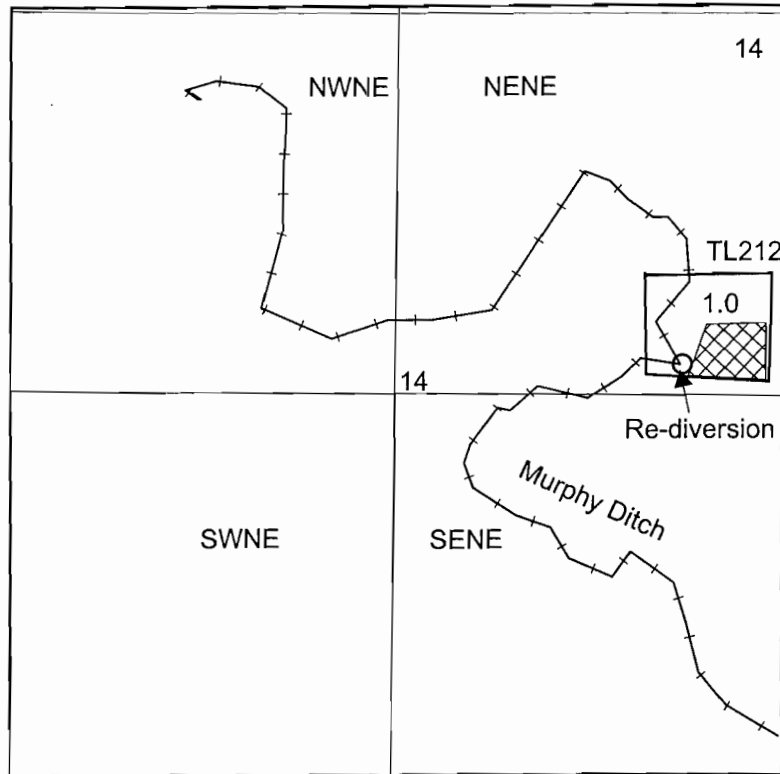

The POD is located
664ft south and
166 ft east from
the north 1/4 corner
of T37S R5W
Sec 19.

1 inch = 660 feet

Final Proof Survey

UNDER

(C49193) Transfer 5317

RECEIVED

APR 28 2011

WATER RESOURCES DEPT
SALEM, OREGON

Applicant: Ronald Himrich, Greg Ross and Dawn Ross