


RECEIVED

FEB 18 2011

WATER RESOURCES DEPT
SALEM, OREGON

T40S R9W Sec12

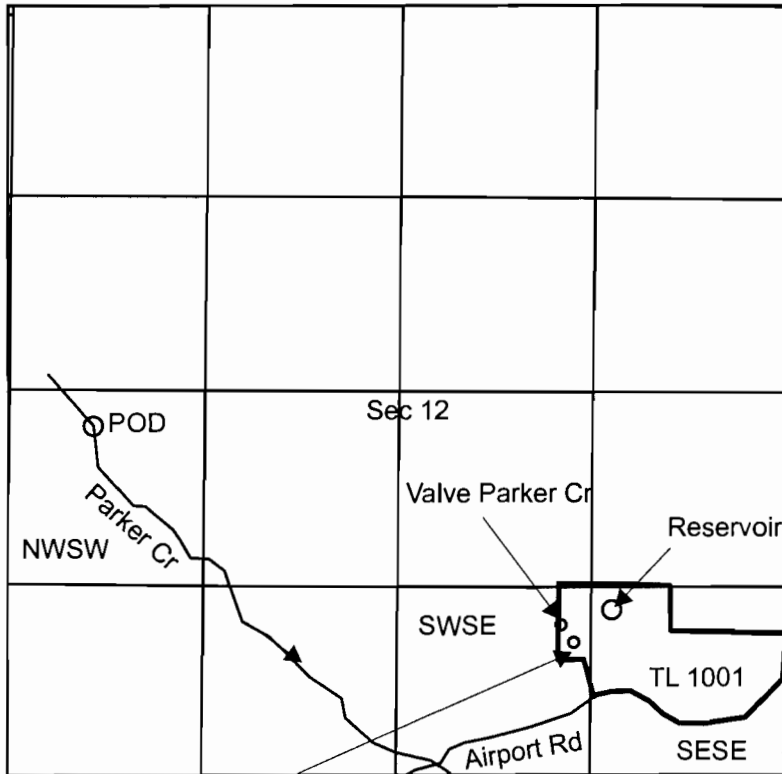

Reservoir is located 1491 ft south and 1213 ft west from the east quarter corner Sec 12

POD on Rough and Ready Creek is 2000 ft north and 700 ft west from the south quarter corner of Sec 14

Valve Rough and Ready Cr

Sec 14

1 inch = 1,320 feet

POD on Parker Creek is 246 ft south and 581 ft east from west quarter corner Sec 12


FINAL PROOF SURVEY

UNDER

Application Nos. **R68806** Permit Nos. **R10818**
S68807 **49923**

IN NAME OF

Thomas K. (Emonds) Lugtenaar

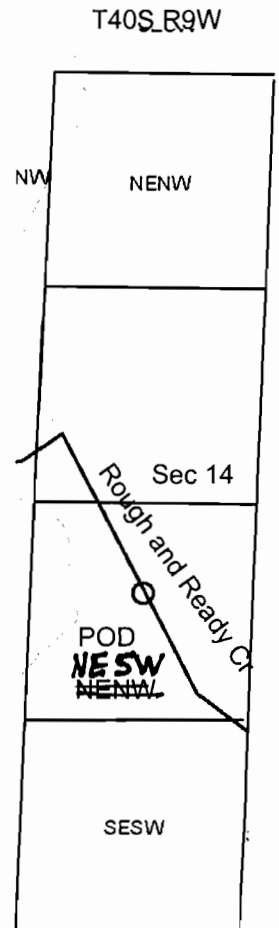

South quarter corner