


T7S R1W & R2W, WM

MARION COUNTY

TAX LOT:
72W 24 100

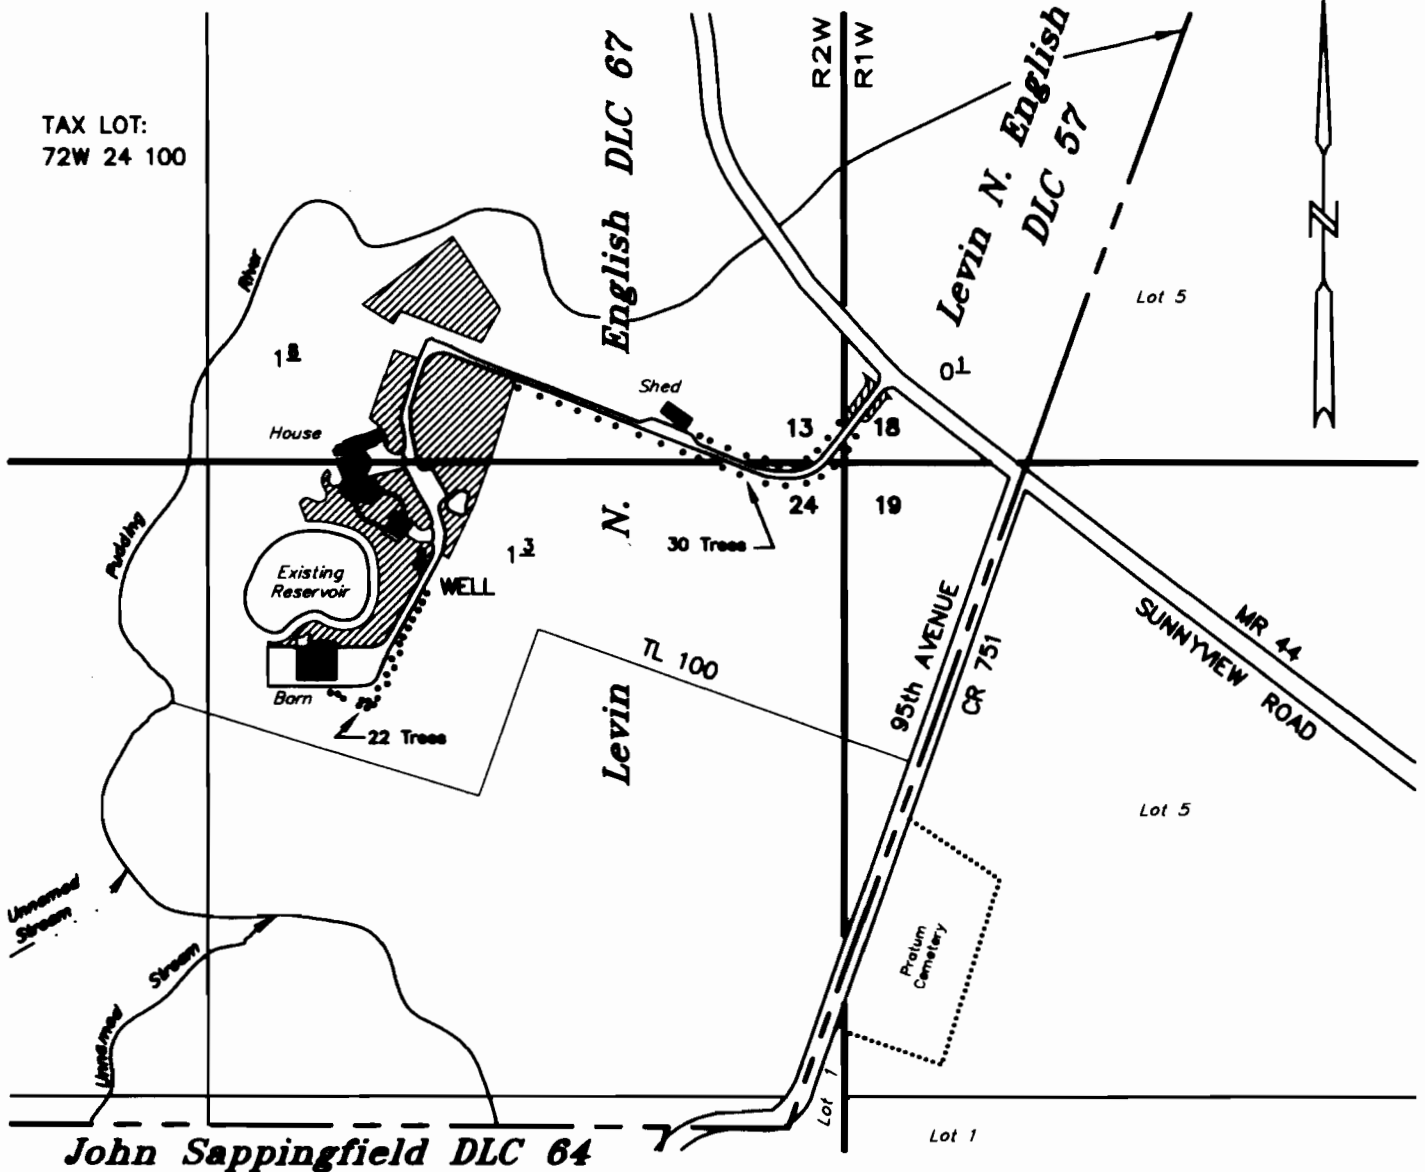

WELL: 1176' N & 755' W FROM THE SE COR LEVIN ENGLISH DLC No. 67

• Individually irrigated tree

Final Proof Survey

UNDER

T-10584 Special Order Volume 75, Page 574

Benjamin & Ashley Johnston

September 21, 2009

SCALE: 1" = 400'

NOTE: This map is for the purpose of identifying the location of water rights and has no intent to dimension or locate property ownership lines.



RENEWAL DATE: 12-31-11