


T4S, R2W, WM

MARION COUNTY

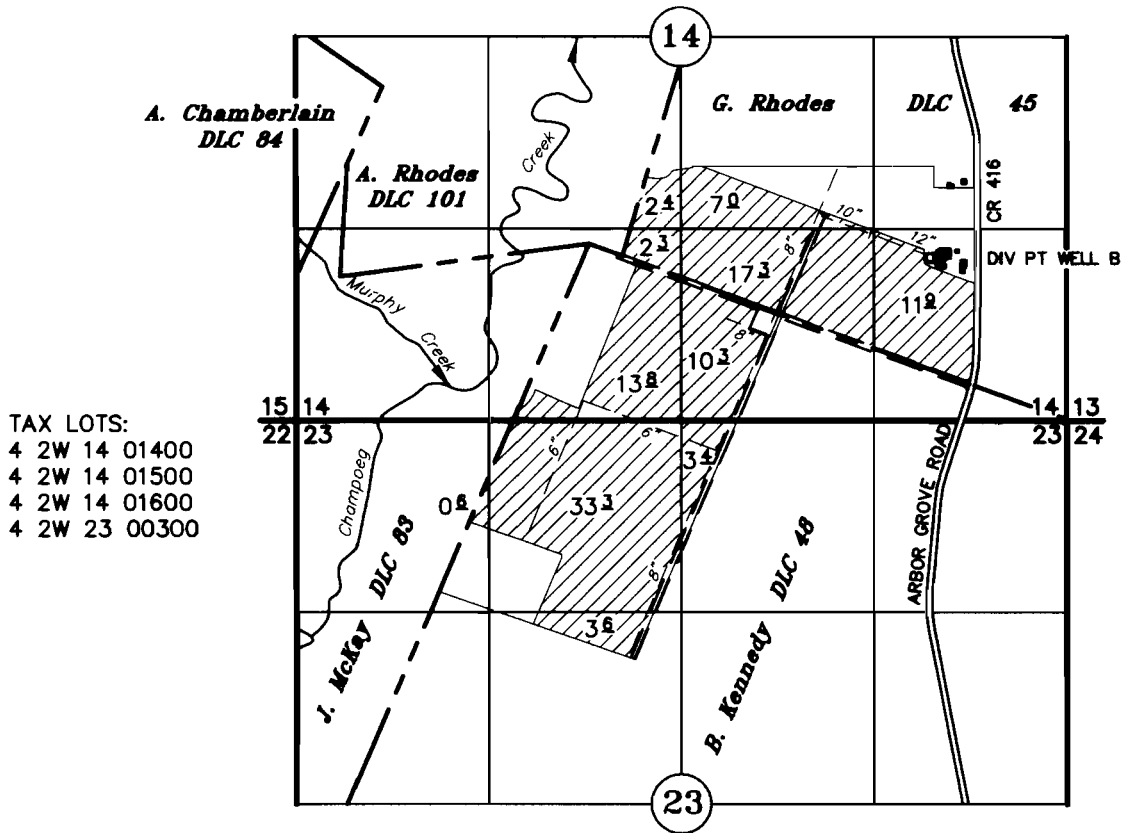

TAX LOTS:
 4 2W 14 01400
 4 2W 14 01500
 4 2W 14 01600
 4 2W 23 00300

DIV PT WELL B: 8' N & 2186' E FROM THE SW G. RHODES DLC 45
 FLOW METER: 10' WEST OF WELL

FINAL PROOF SURVEY


UNDER

Application No. G-16250 Permit No. G-16423

ADAPS LLC

IN THE NAME OF

SEPTEMBER 30, 2010
 SCALE: 1" = 1320'

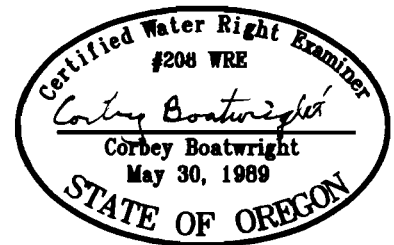

NOTE: This map is for the purpose of identifying the location of water rights and has no intent to dimension or locate property ownership lines.

RENEWAL DATE: DEC 31, 2011