


T.35S., R.3W., W.M.

RECEIVED

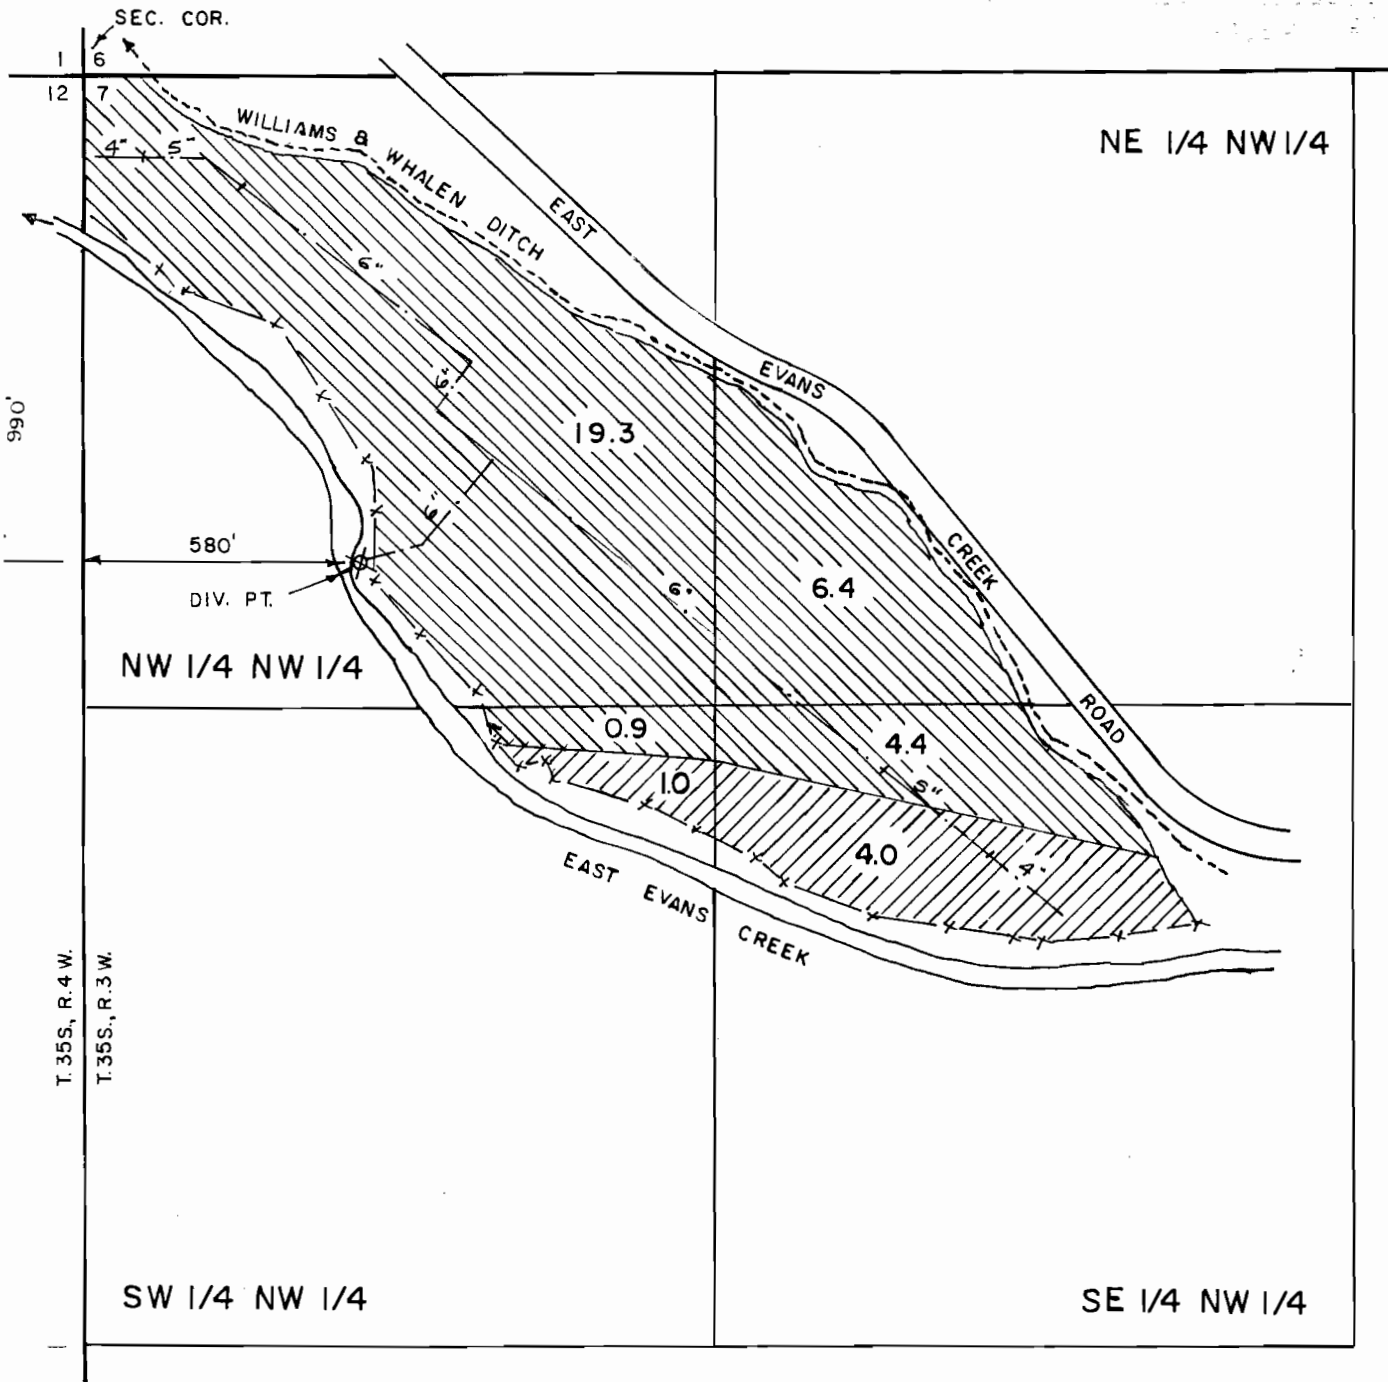

FINAL PROOF MAP

TRANSFER No. T-6887

IN THE NAME OF

DAN KEWISH

MAP PREPARED FEBRUARY 15, 1995

BY GARY D. KAISER



CERT. 16113



CERT. 7821
PERMIT 7911

NOTE: MAP PREPARED FOR
WATER RIGHT PURPOSES ONLY,
NOT FOR PROPERTY BOUNDARY
LOCATIONS.

S.D.K.