


SCALE: 1"=1320'

Well #4 is located 50 feet North and 250 feet West of the Southeast corner of Section 1 Township 2 South Range 38 East.

Lands with primary water rights from well #4.

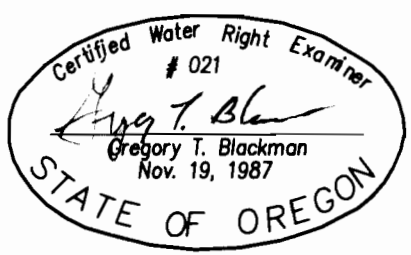

January 19, 2005  
**FINAL PROOF MAP OF WATER RIGHTS FROM WELL #4**  
 FOR  
**John & Marita Cuthbert**

NOTE: The preparation of this map was for the purpose of identifying the location of the proposed water right and has no intent to provide dimensions or location of property ownership lines. Location information shown hereon was furnished by the applicant.

BY  
**BAGETT - GRIFFITH & BLACKMAN**  
 2006 ADAMS AVENUE  
 LAGRANDE, OREGON 97850

Application No. G-15921  
 Permit Number G-15549

