
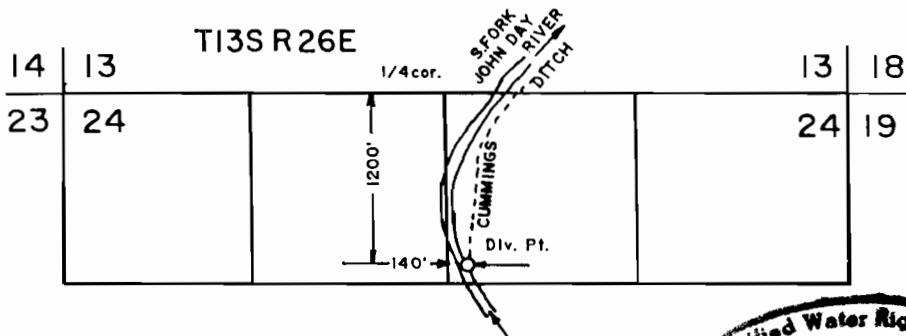



T13S, R26 & 27E, W.M.

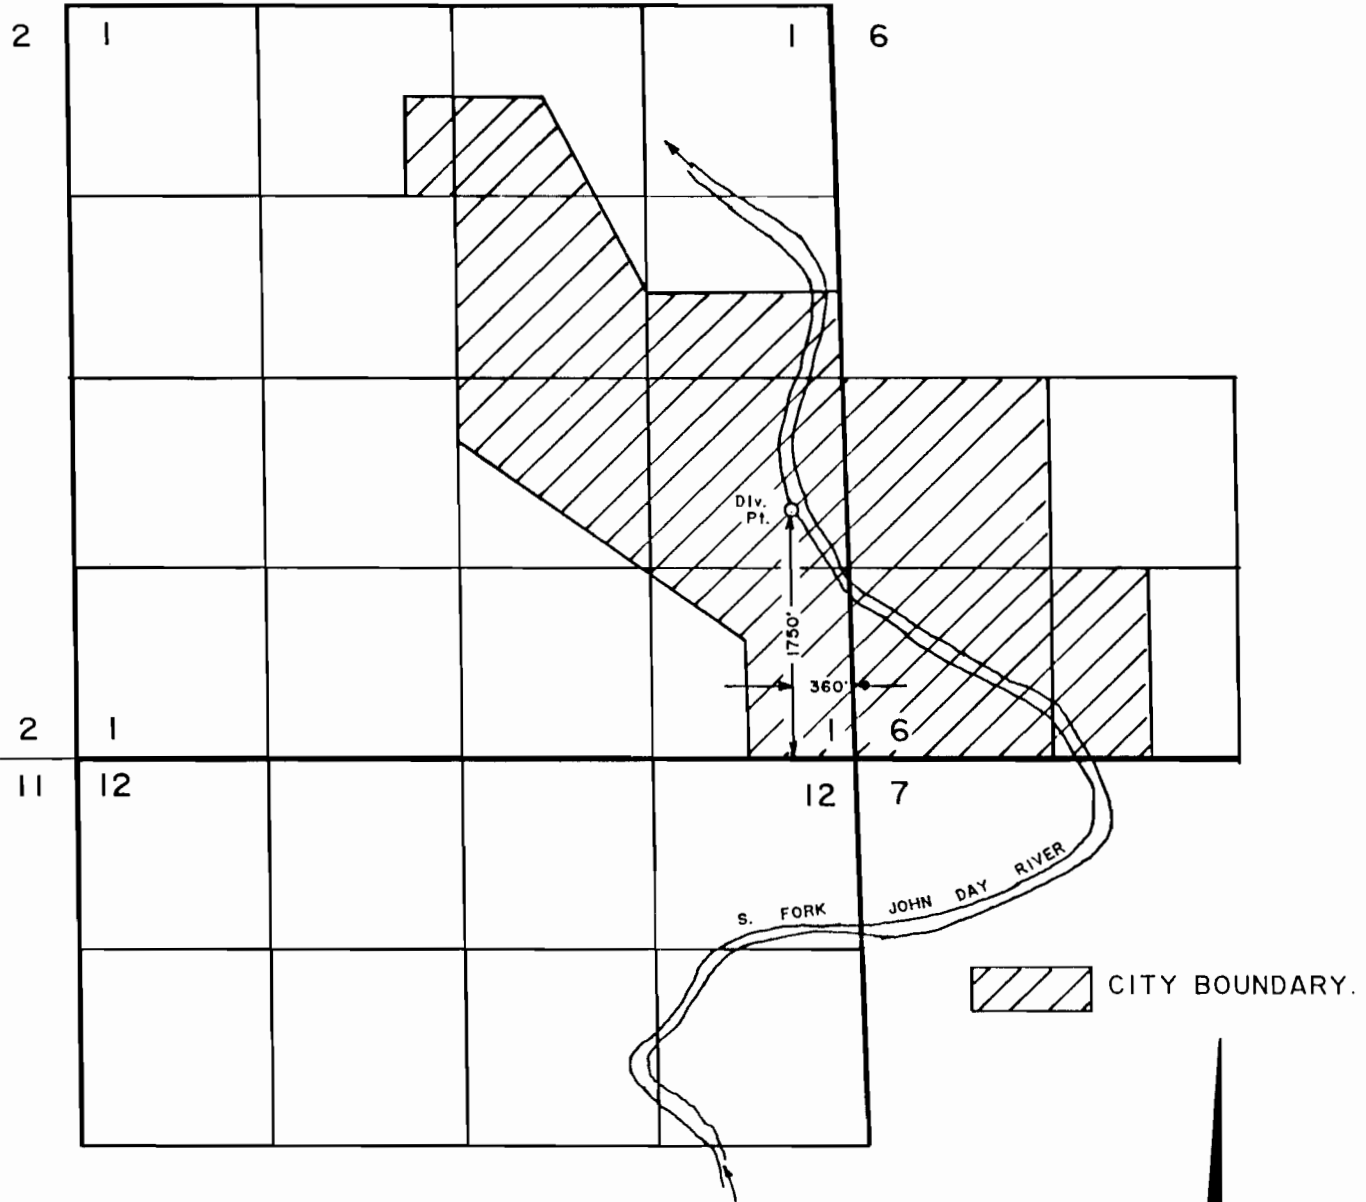

FINAL PROOF SURVEY  
UNDER

TRANSFER NO. T-6317  
IN NAME OF  
CITY OF DAYVILLE

SURVEYED FEB. 21, 1991 BY *Robert D. Baggett*

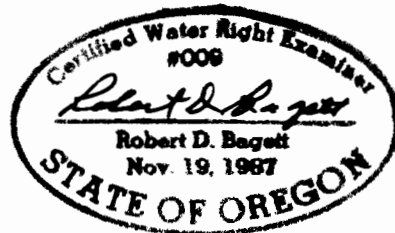

Scale 1" = 1320'

