


T. 6S. R. 1W. W.M.

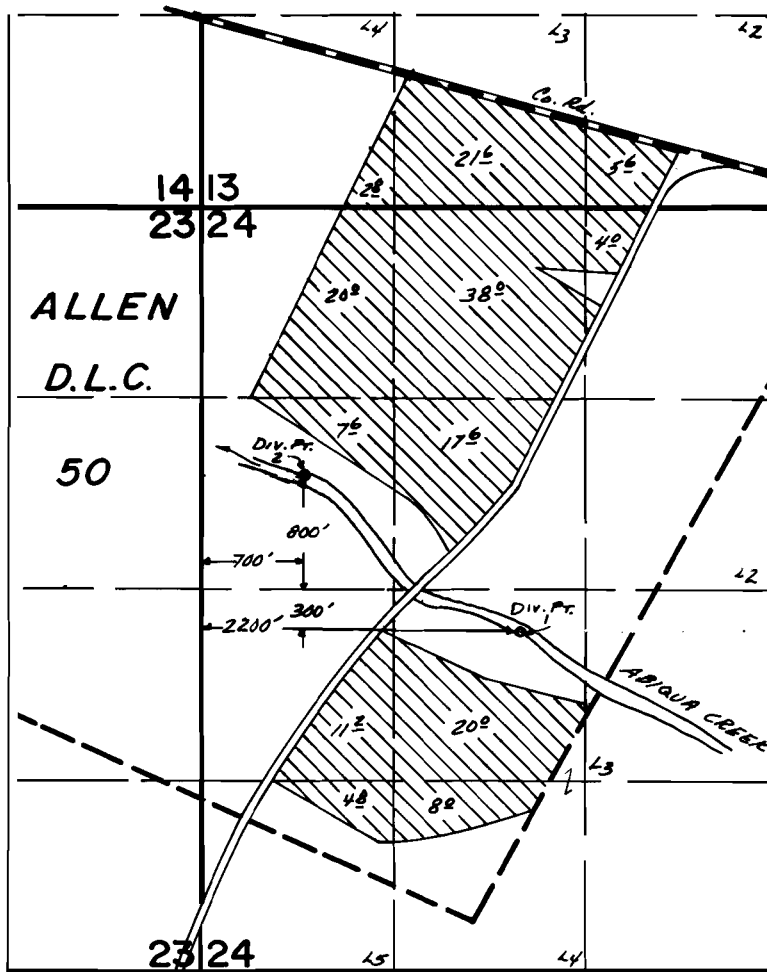

FINAL PROOF SURVEY UNDER

Application No. 53924... Permit No. 40232...
IN NAME OF

MOUNT ANGEL ABBEY

Surveyed Oct. 12, 1978, by J.S. Donaldson.