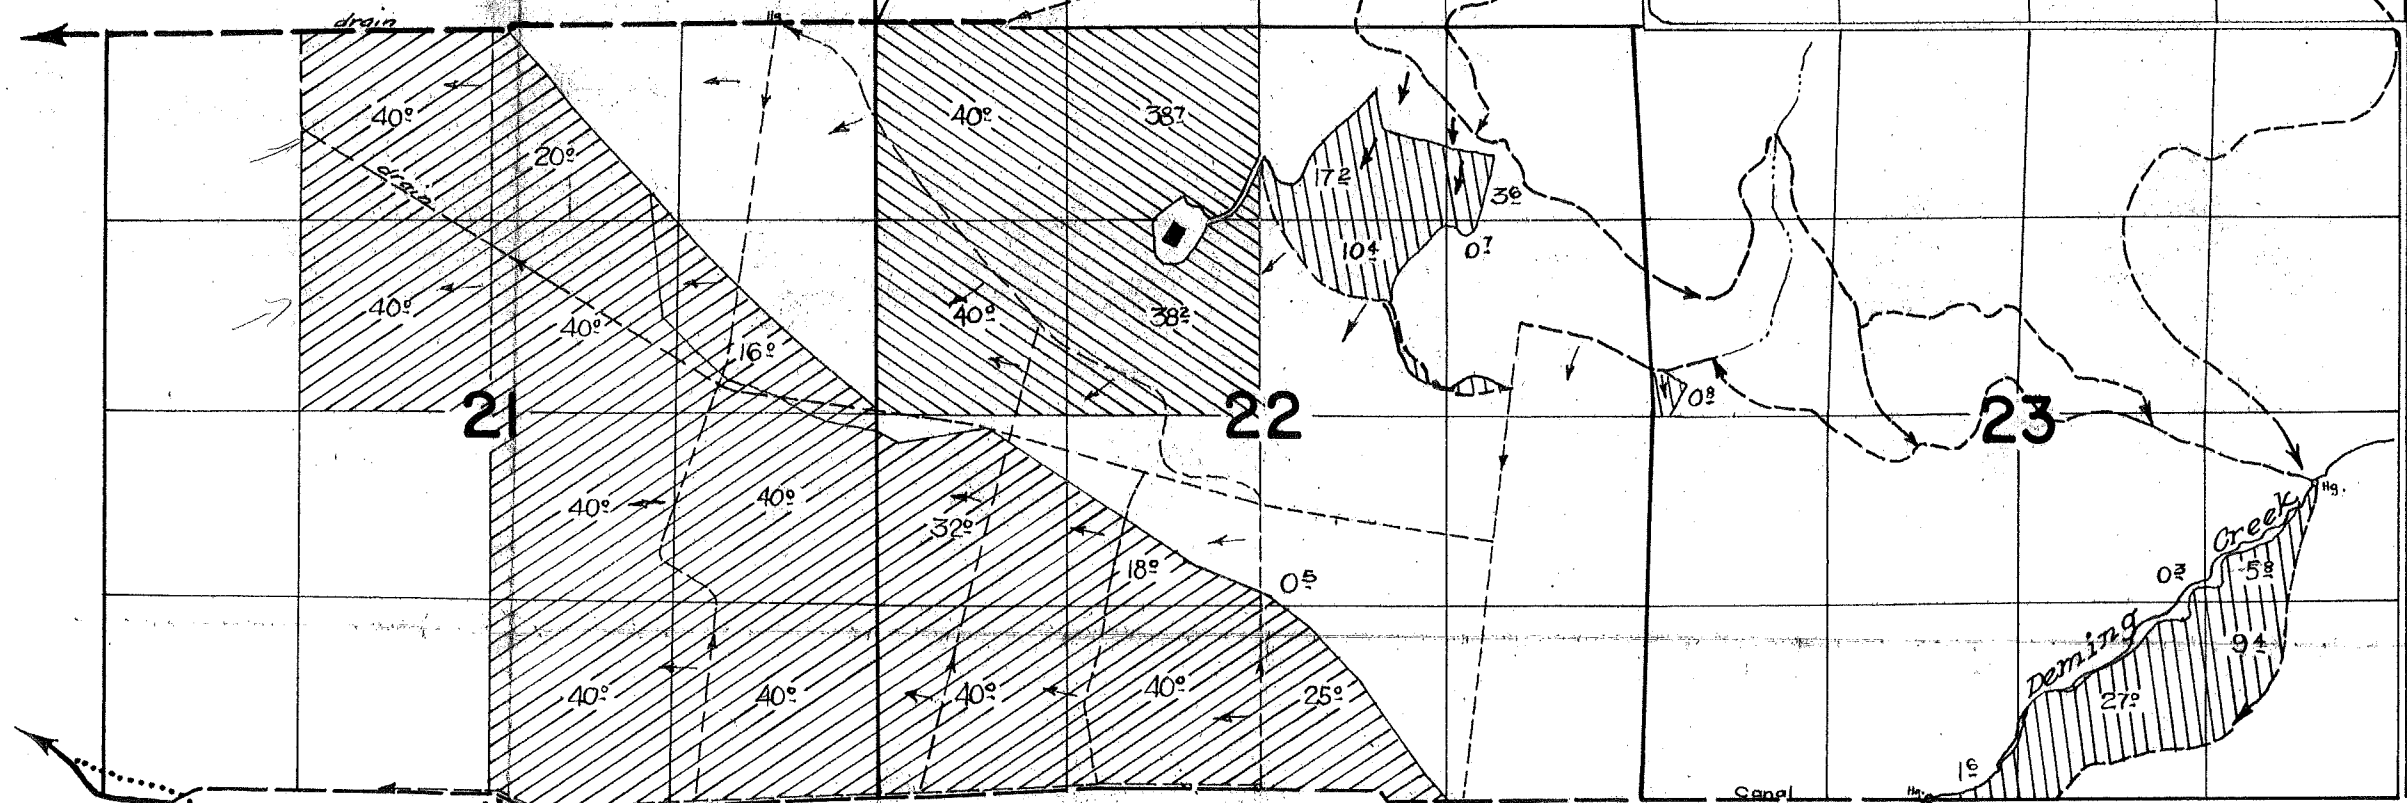
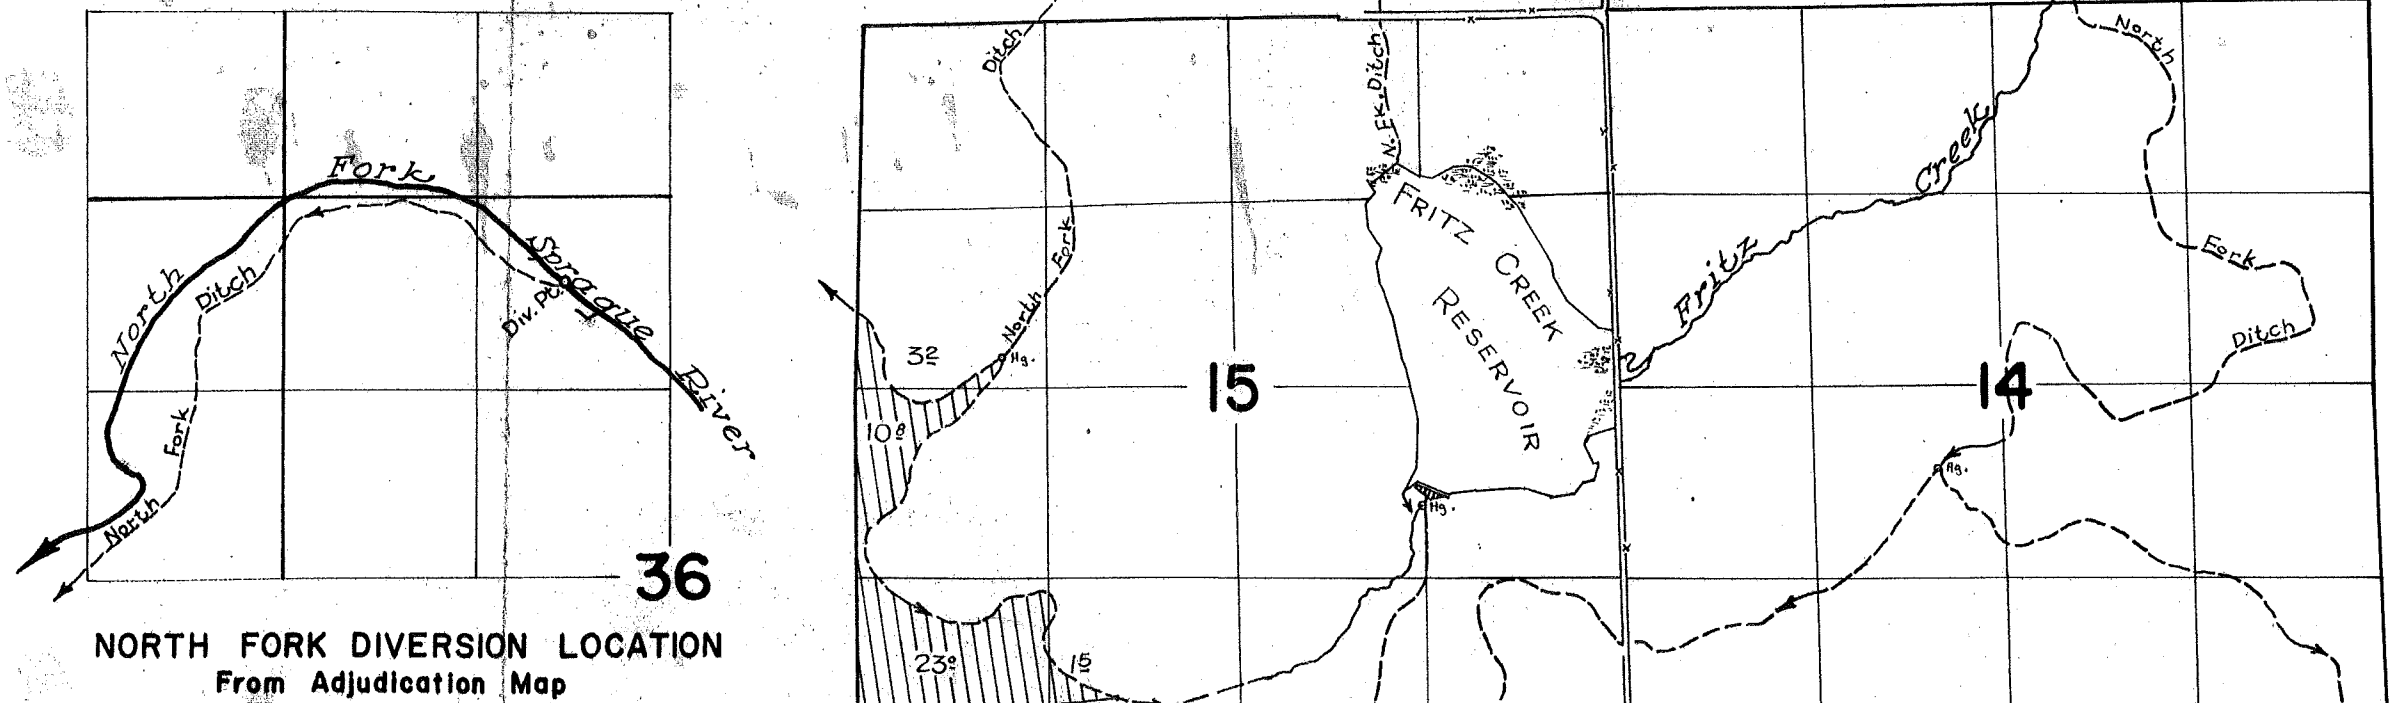


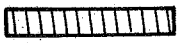

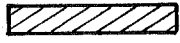
T.35S.R.14E.W.M.

T.36S.R.14E.W.M.



FINAL PROOF SURVEY

UNDER

Application 25527	Permit 23741	
R-28647	R-1553	
28648	22565	
30526	24036	

Old Channel
South Fork Sprague R.
Relocated Channel