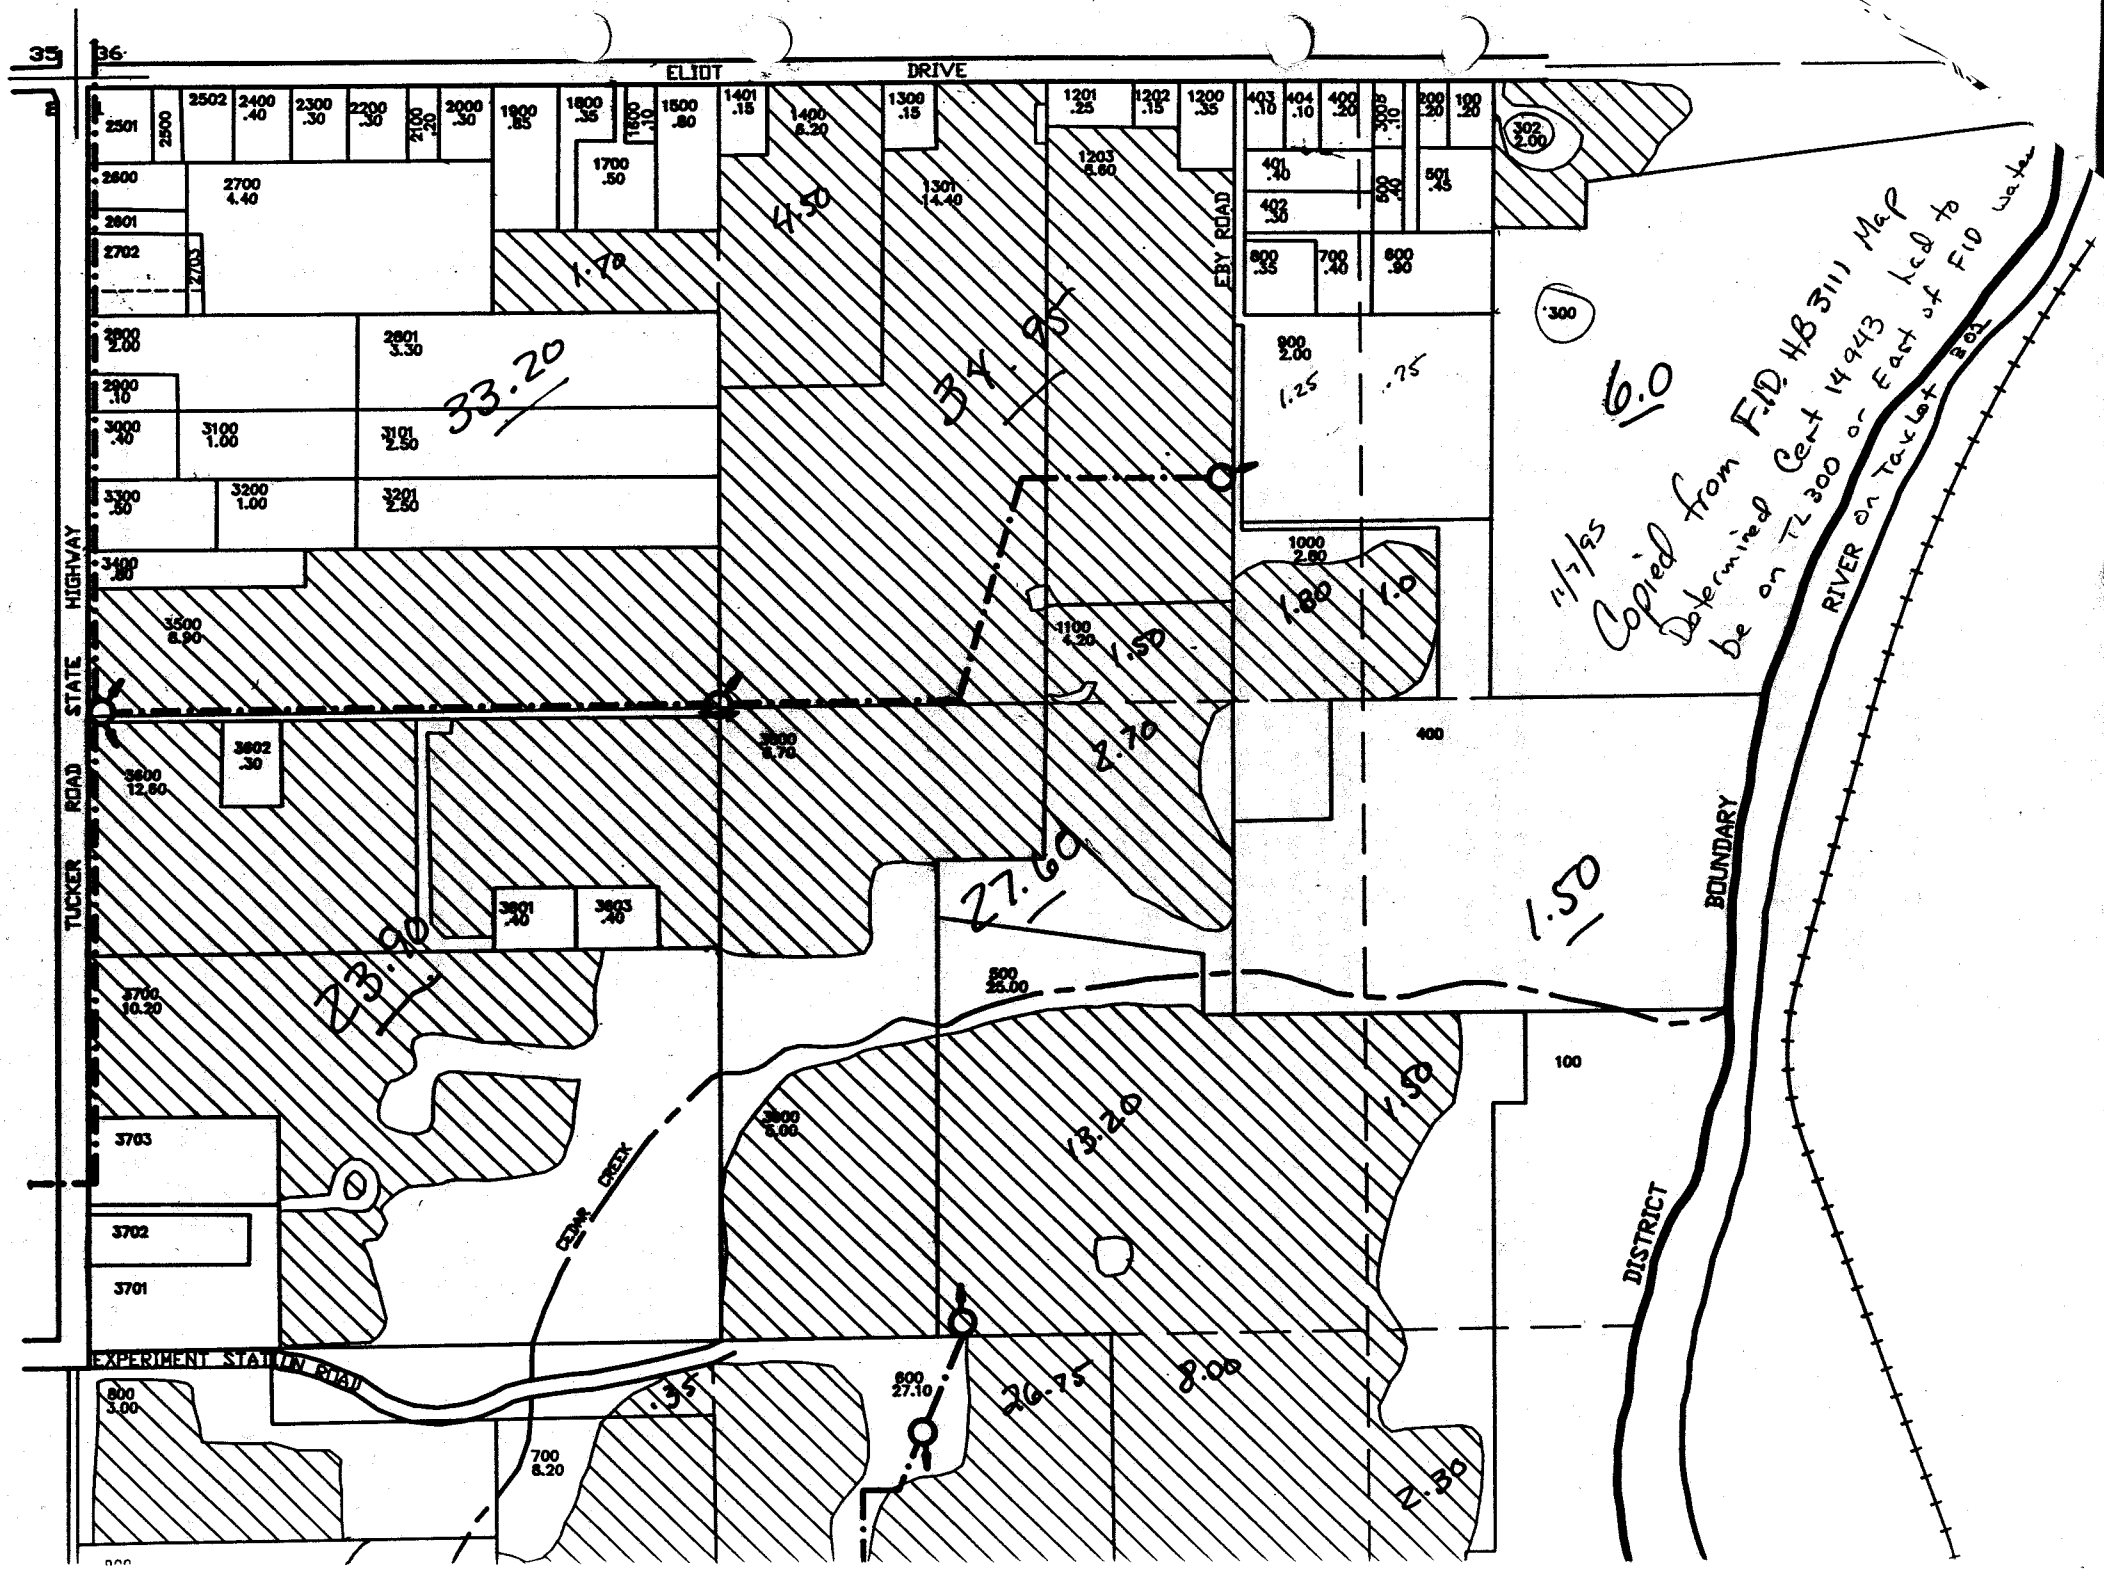
35
36
ELIOT DRIVE
TUCKER ROAD STATE HIGHWAY
EBY ROAD
EXPERIMENT STATION ROAD
CEDAR CREEK
DISTRICT BOUNDARY
RIVER on Tax Lot 300
11/7/95
Copied from F.I.D. HB 3111 Map
Determined Cent 14943 had to
be on TL 300 or East of F.I.D. water

10 E

5–1–4

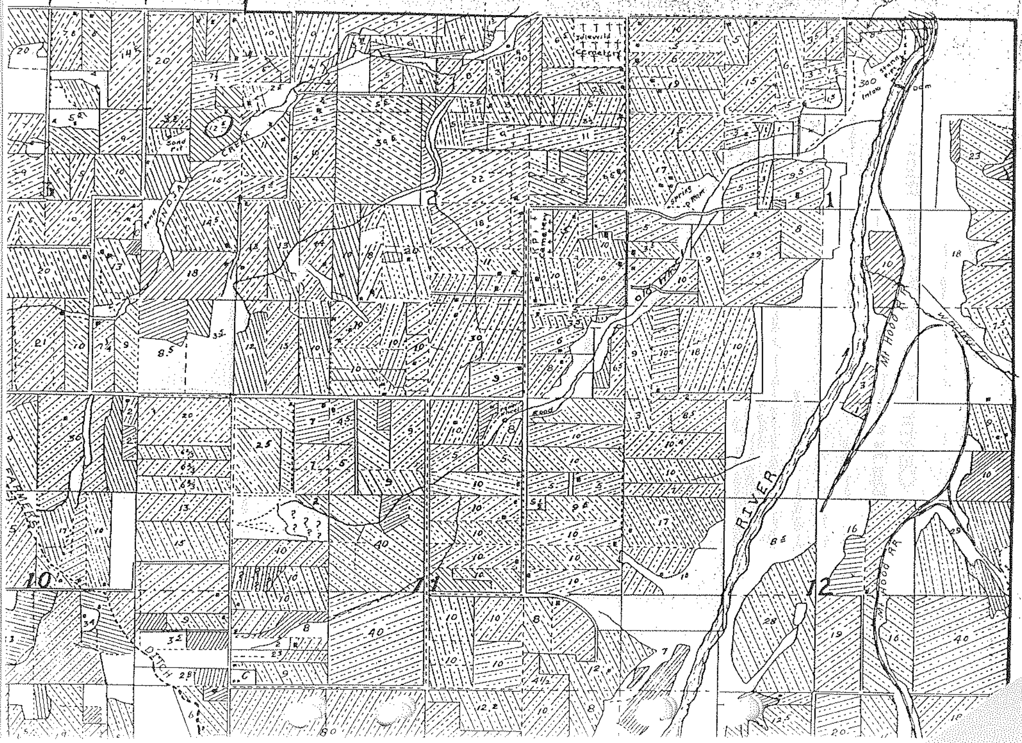
Idlewild Cemetery
Sand Pit
CREEK
Cemetery
Spring
Old Hwy
Road
Intake pipe
Dam
Mt Hood RR
RIVER
FARMERS
DITCH
1
10
11
12