


**CLAIM OF BENEFICIAL USE MAP
FOR COLUMBIA EMPIRE FARMS (R-2 RANCH)
FOR APPLN R-84331, PERMIT R-12964, PERMIT AMENDMENT T-9009,
AND APPLN R-86962, PERMIT R-14625**

T. 9 S., R. 15 E., W.M.

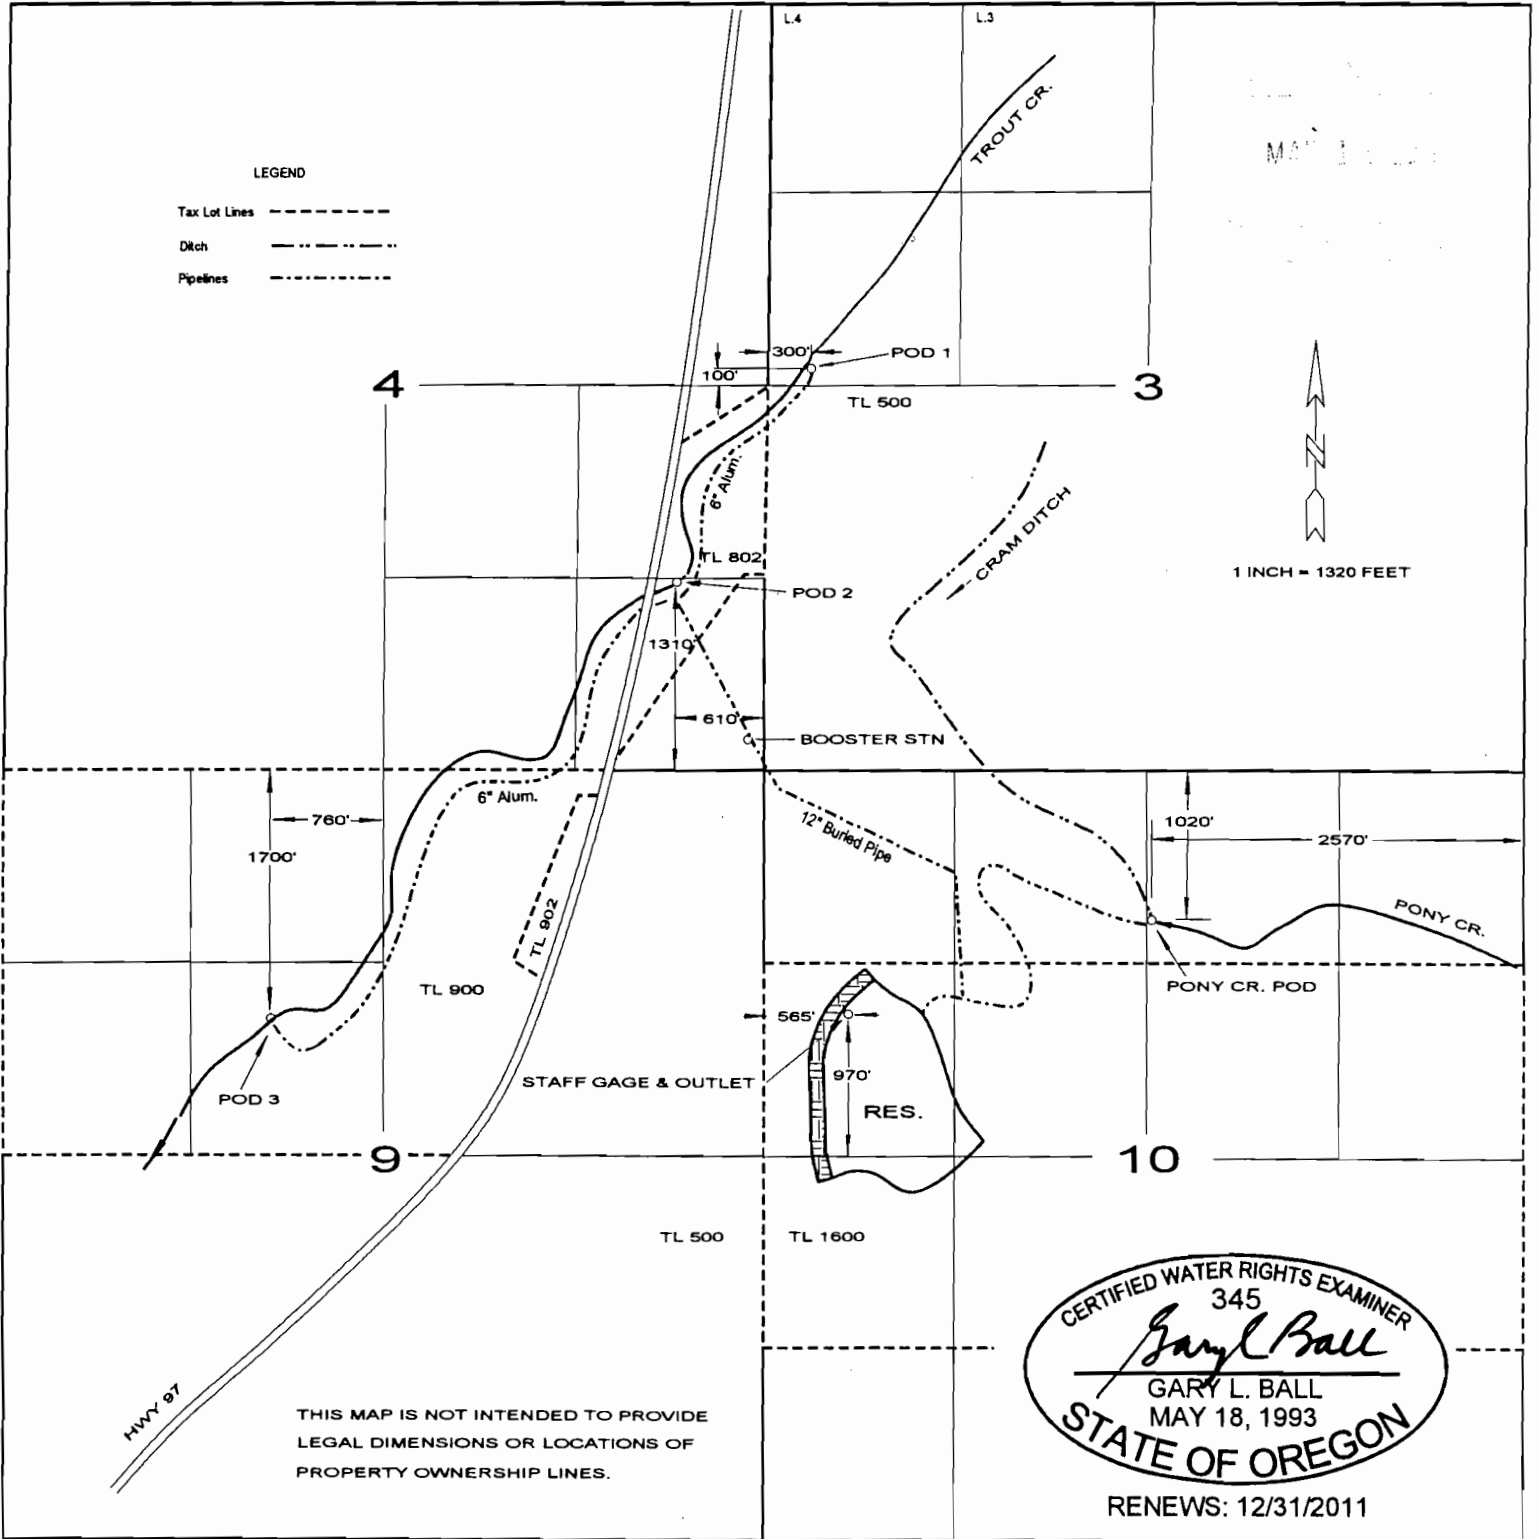

THIS MAP IS NOT INTENDED TO PROVIDE
LEGAL DIMENSIONS OR LOCATIONS OF
PROPERTY OWNERSHIP LINES.

CERTIFIED WATER RIGHTS EXAMINER
 345
Gary L. Ball
 GARY L. BALL
 MAY 18, 1993
 STATE OF OREGON

RENEWS: 12/31/2011