


RECEIVED

Claim of Beneficial Use Place of Use Map

Transfer T-9809, Permit G-443

Township 1 North, Range 3 East (W.M.)

WATER RIGHTS DIVISION
SALEM, OREGON

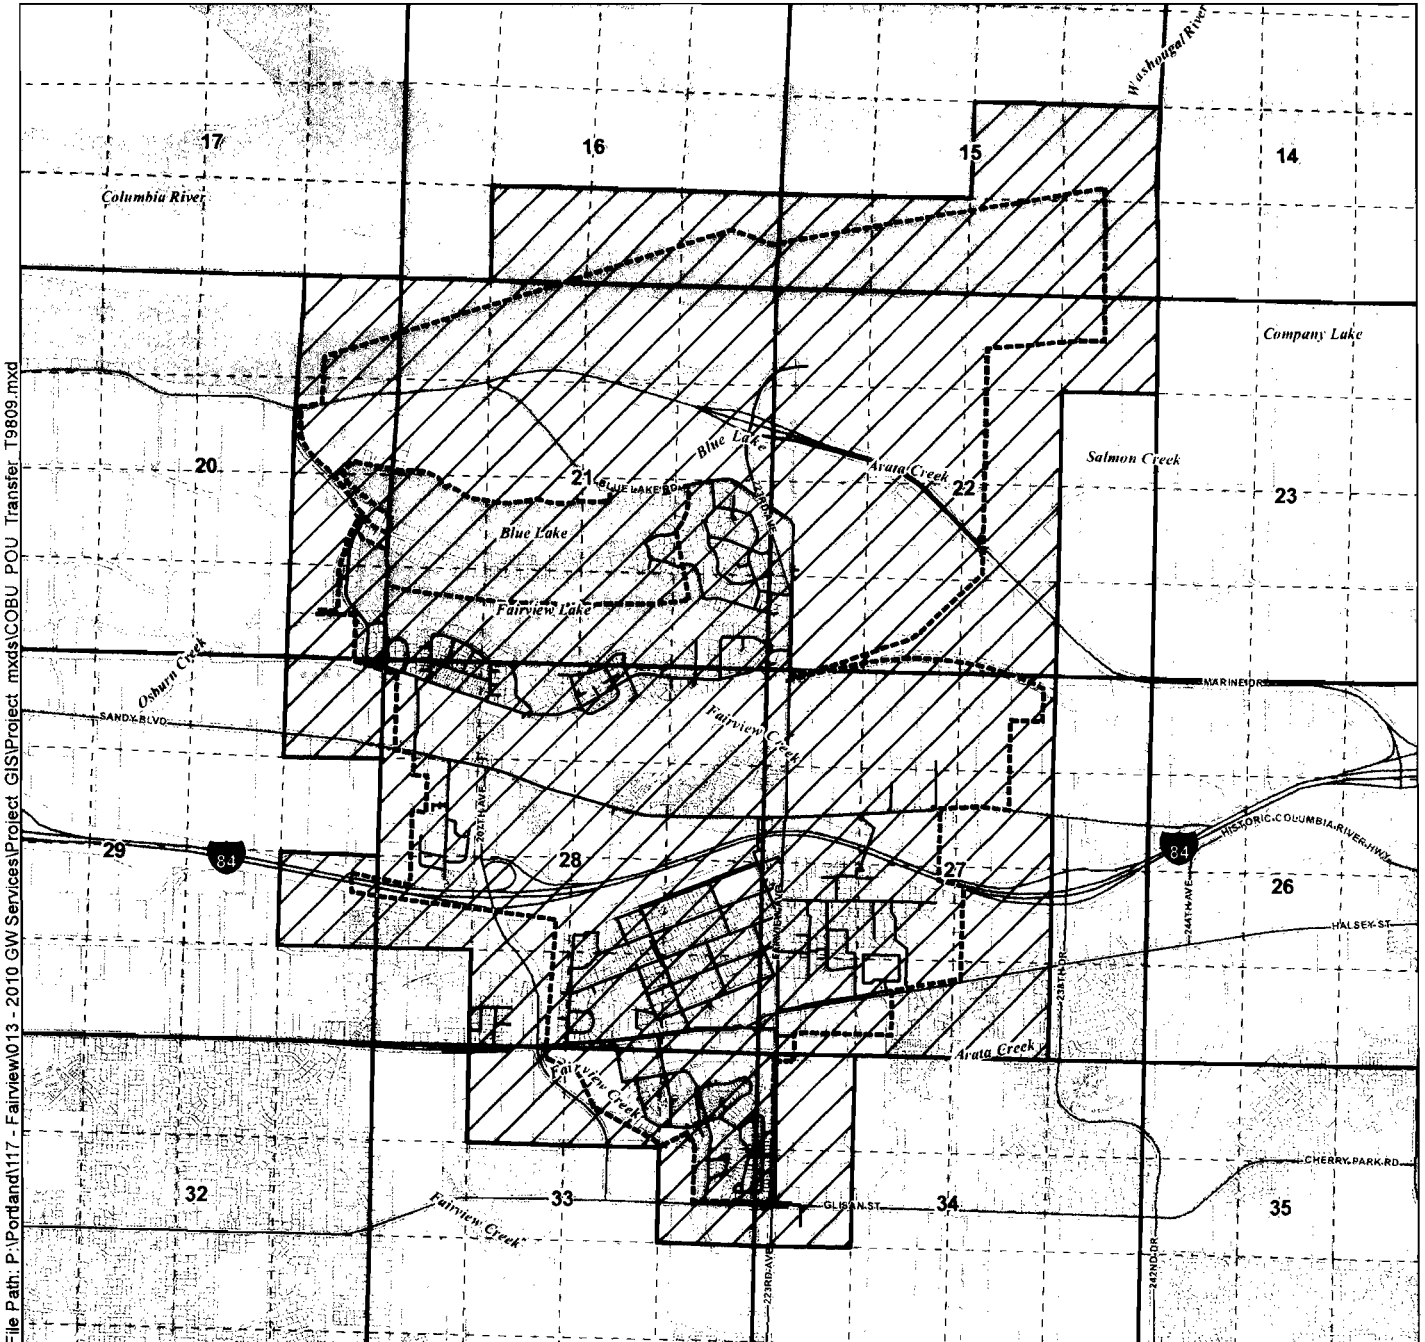


File Path: P:\Portland\117 - Fairview\013 - 2010 GW Services\Project GIS\Project mxd\COBU POU Transfer_T9809.mxd

LEGEND

- Place of Use (POU)
- City of Fairview Service Area Boundary
- Water Mainlines
- Tax Lots
- Major Roads
- Watercourses
- Waterbodies

Certified Water Rights Examiner Stamp

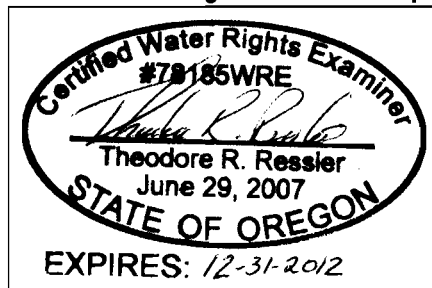


Disclaimer

This map was prepared for the purpose of identifying the location of a water right only and it is not intended to provide legal dimensions or location of property ownership lines.

Map Notes

Date: October 15, 2010
Data Sources: Oregon Geospatial Data Clearinghouse, METRO RLIS
Prepared By: GSI Water Solutions, Inc.

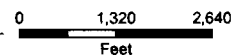


RECEIVED

Claim of Beneficial Use Point of Appropriation Map

Transfer T-9809, Permit G-443

Township 1 North, Range 3 East (W.M.)

WATER RESOURCES DEPT
SALEM OREGON

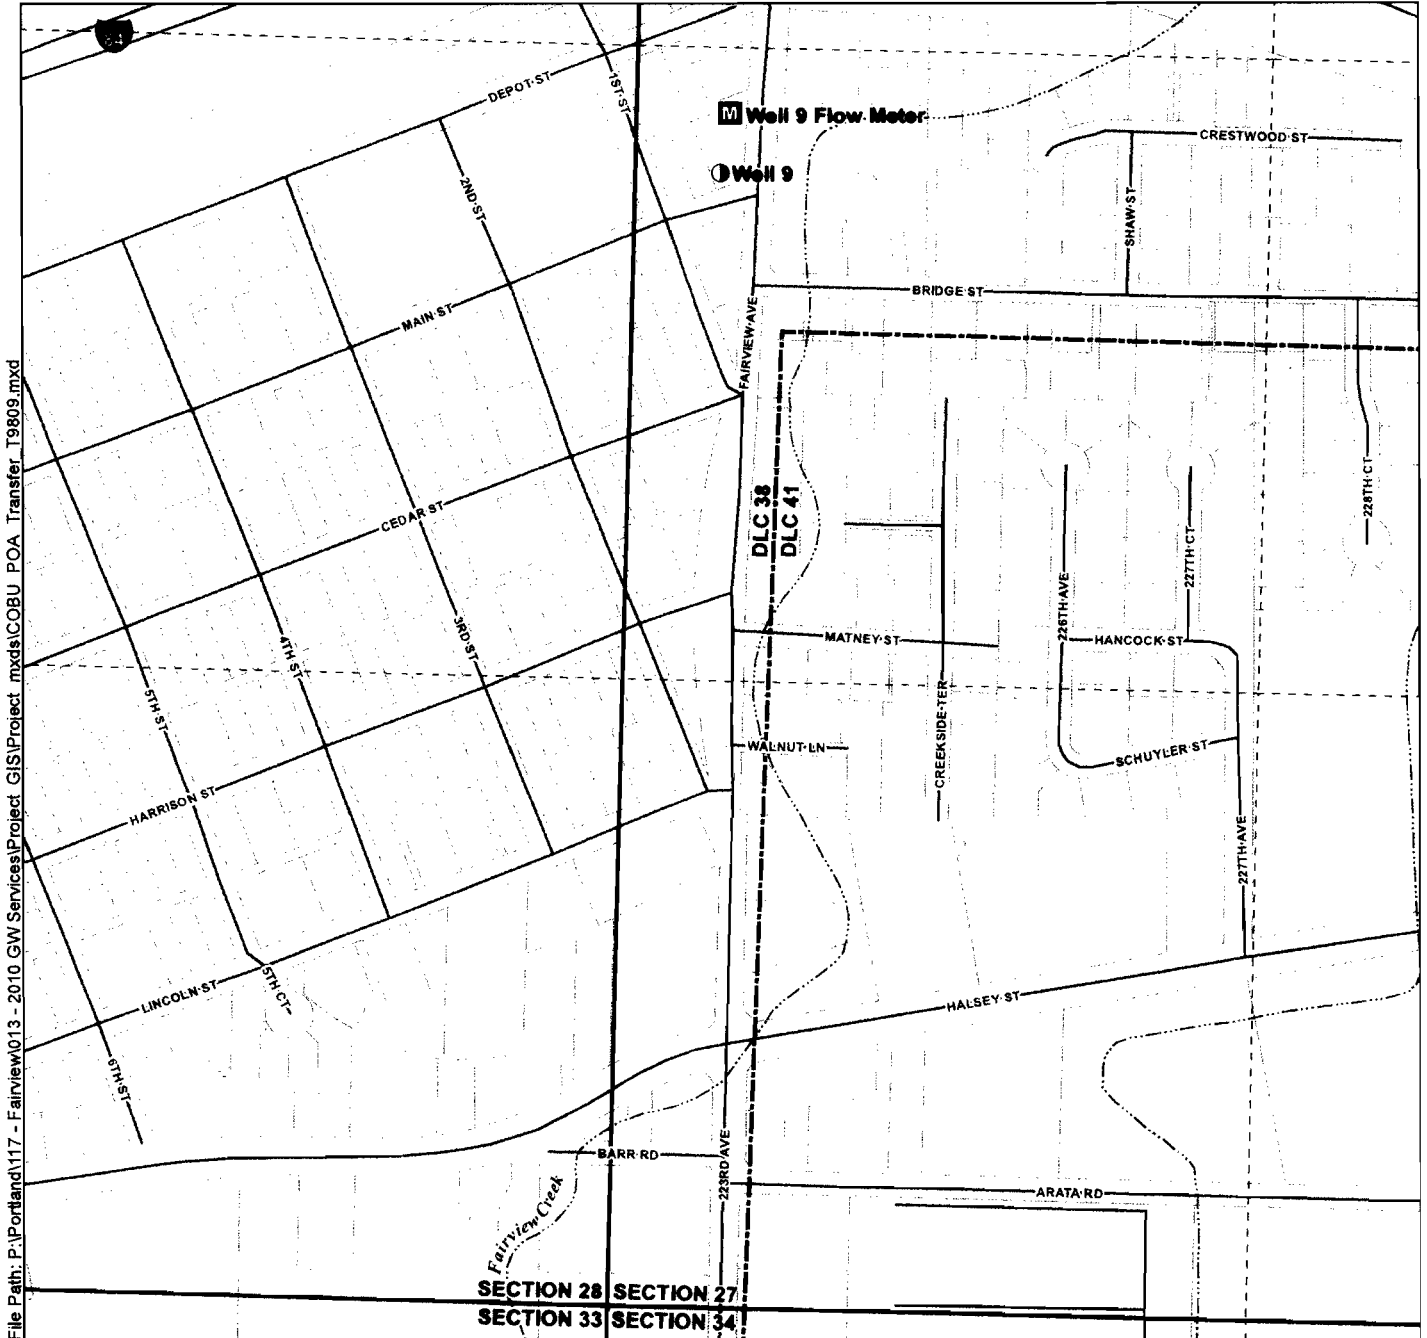

File Path: P:\Portland\117 - Fairview\013 - 2010 GW Services\Project GIS\Project_mxd\COBU_POA_Transfer_T9809.mxd


LEGEND

- Point of Appropriation (POAs)
- Well Flow Meter
- ▭ Tax Lots
- Roads
- ~ Watercourses

POA Location Description

Point of Appropriation - Well 9
Located 2,375 feet North and 180 feet East from the SW corner of Section 27, Township 1 North, Range 3 East (W.M.)

Certified Water Rights Examiner Stamp

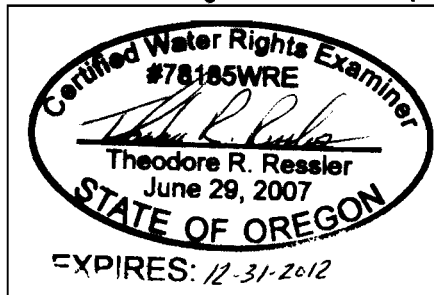

Disclaimer

This map was prepared for the purpose of identifying the location of a water right only and it is not intended to provide legal dimensions or location of property ownership lines.

Map Notes

Date: October 15, 2010
Data Sources: Oregon Geospatial Data Clearinghouse, METRO RLIS
Prepared By: GSI Water Solutions, Inc.

