

RECEIVED


FEB 08 2011

WATER RESOURCES DEPT
SALEM, OREGON

Claim of Beneficial Use Point of Appropriation Map

Permit G-5594, Application G-5857

Township 1 North, Range 3 East (W.M.)

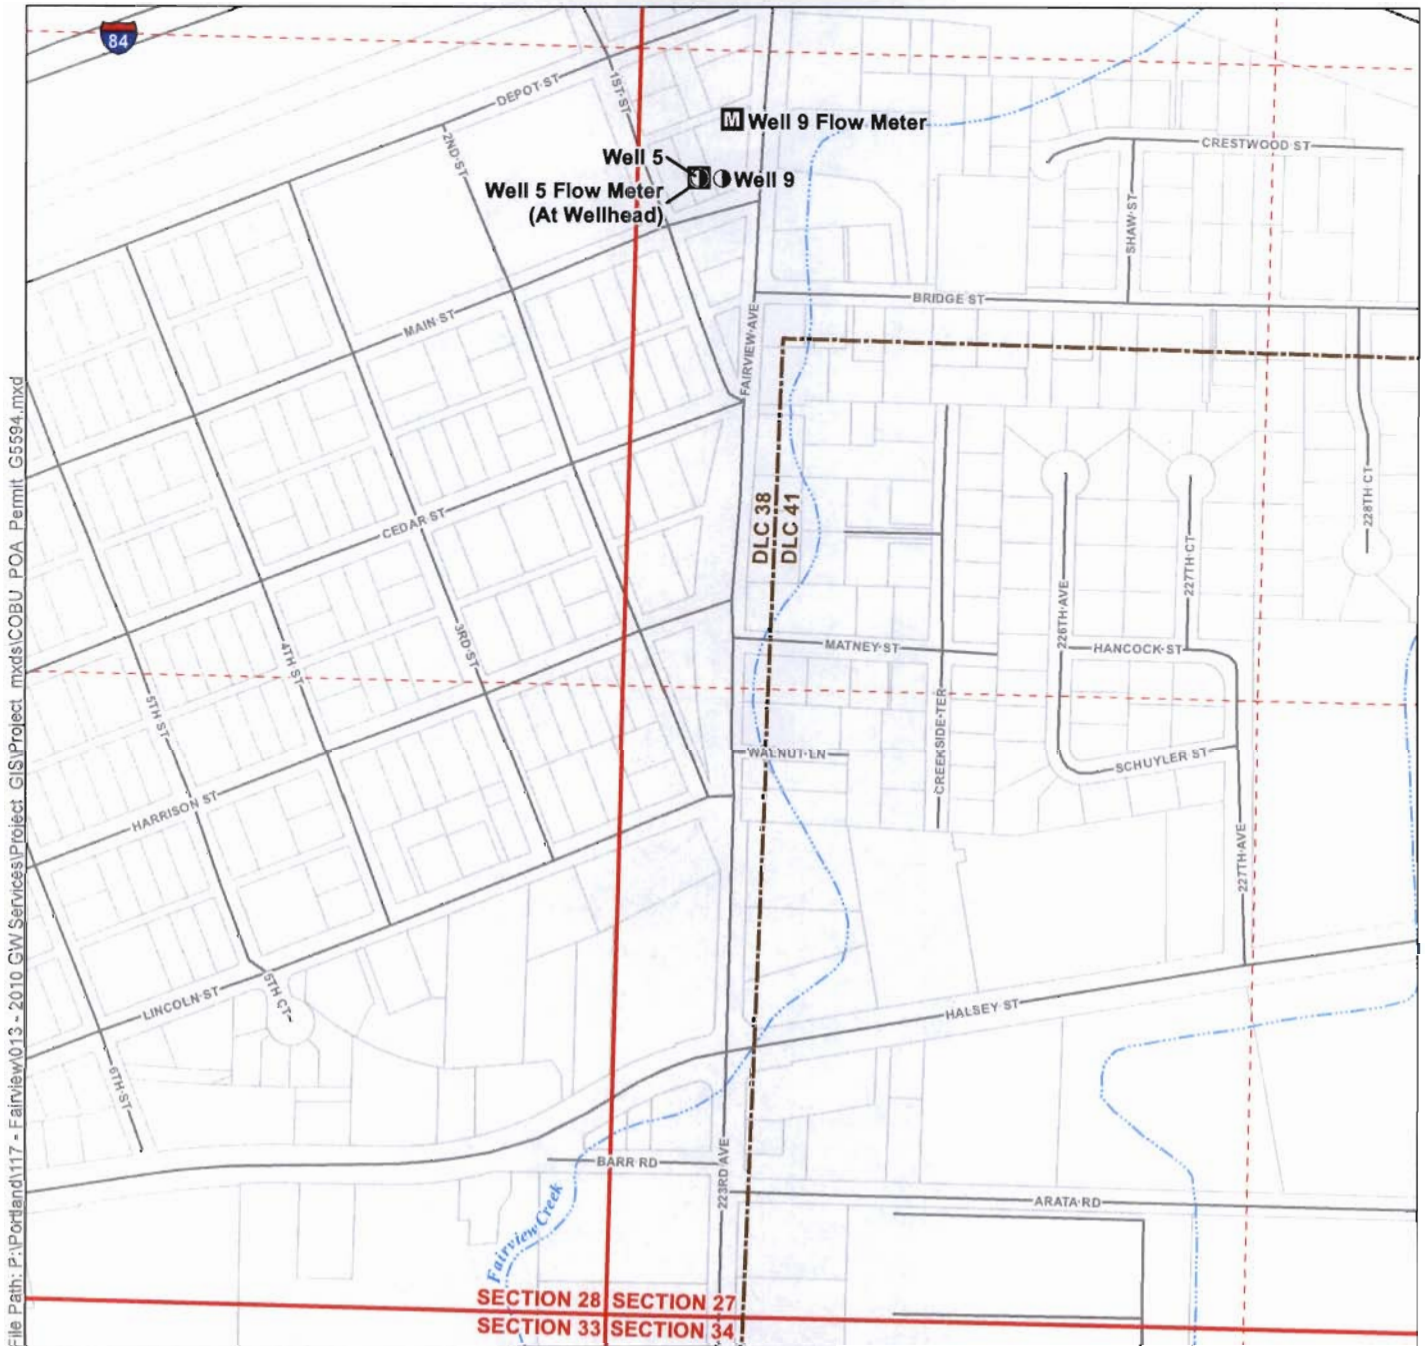

LEGEND

- Points of Appropriation (POAs)
- Well Flow Meters
- Tax Lots
- Roads
- Watercourses

POA Location Descriptions

Point of Appropriation - Well 5
Located 2,380 feet North and 130 feet East from the SW corner of Section 27, Township 1 North, Range 3 East (W.M.)

Point of Appropriation - Well 9
Located 2,375 feet North and 180 feet East from the SW corner of Section 27, Township 1 North, Range 3 East (W.M.)

Certified Water Rights Examiner Stamp




Disclaimer

This map was prepared for the purpose of identifying the location of a water right only and it is not intended to provide legal dimensions or location of property ownership lines.

Map Notes

Date: October 15, 2010
Data Sources: Oregon Geospatial Data Clearinghouse, METRO RLIS
Prepared By: GSI Water Solutions, Inc.

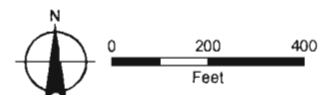

RECEIVED


FEB 08 2011

WATER RESOURCES DEPT
SALEM, OREGON

Claim of Beneficial Use Place of Use Map

Permit G-5594, Application G-5857

Township 1 North, Range 3 East (W.M.)

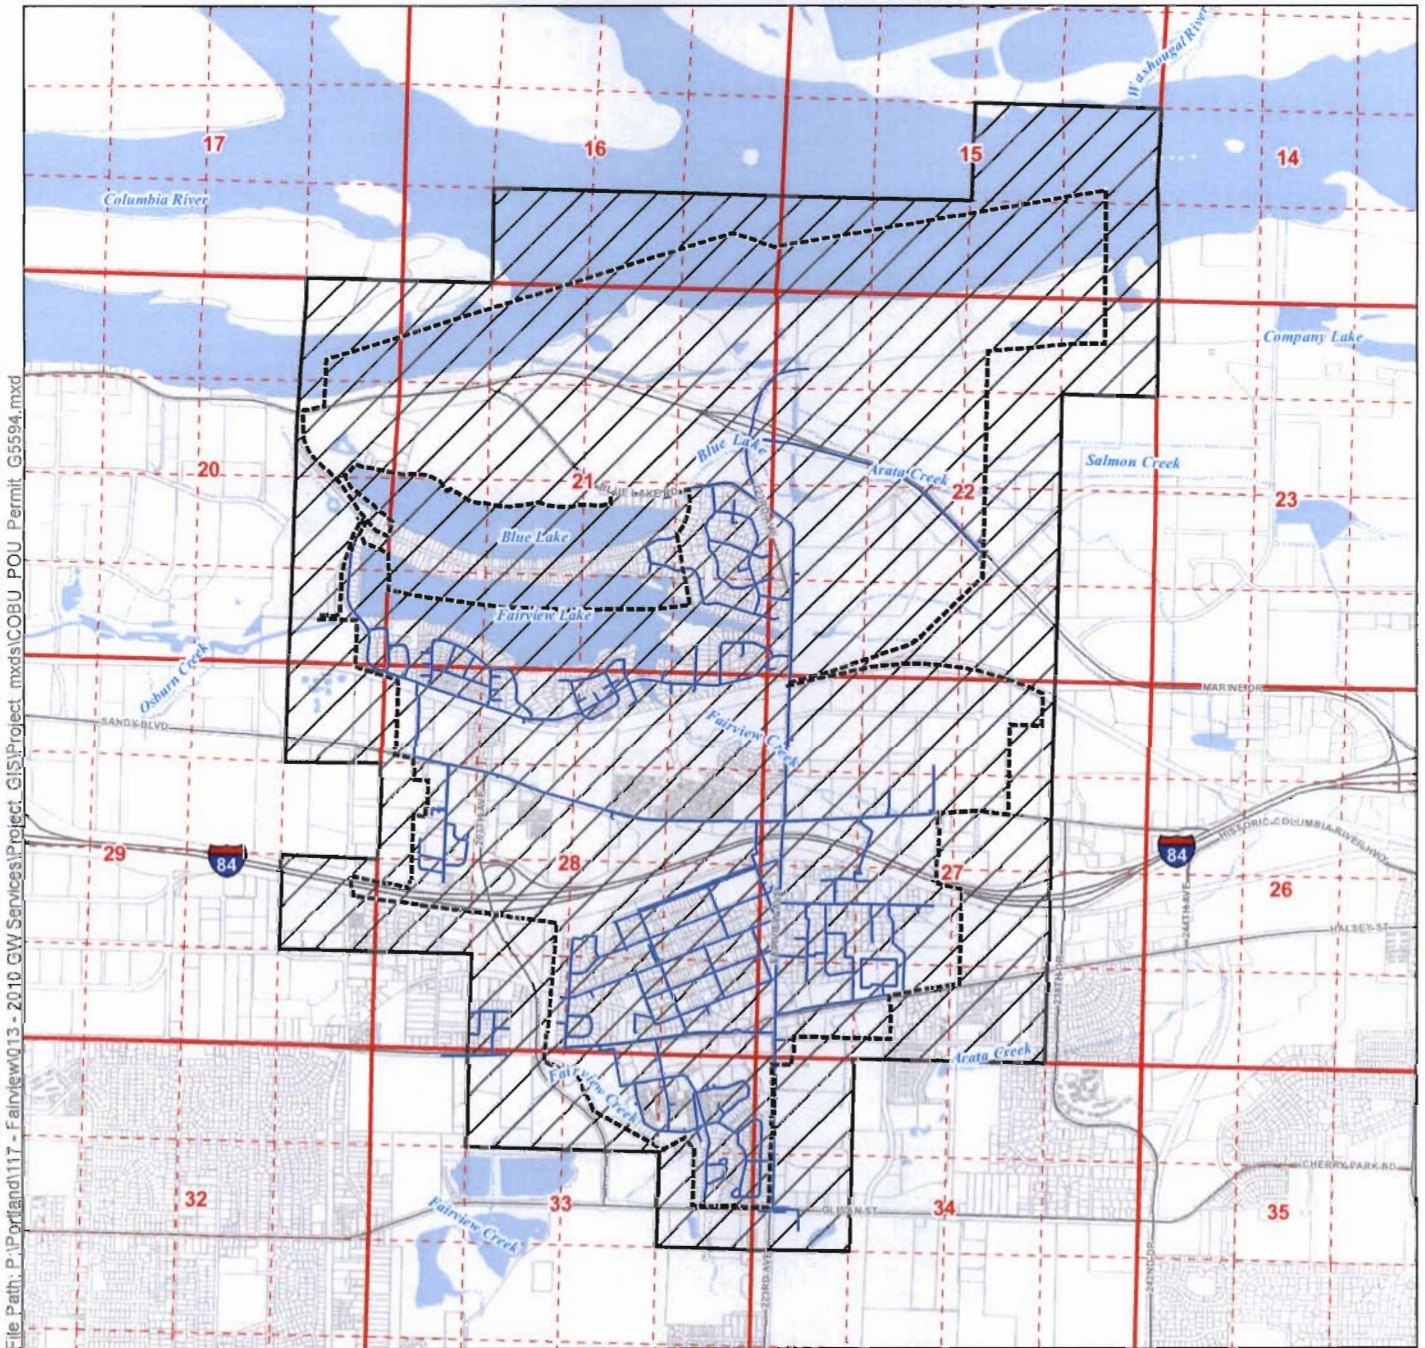


File Path: P:\Portland\117 - Fairview\013 - 2010 GW Services\Project_GIS\Project_mxd\COBU_POU_Permit_G5594.mxd

LEGEND

- Place of Use (POU)
- City of Fairview Service Area Boundary
- Water Mainlines
- Tax Lots
- Major Roads
- Watercourses
- Waterbodies

Certified Water Rights Examiner Stamp

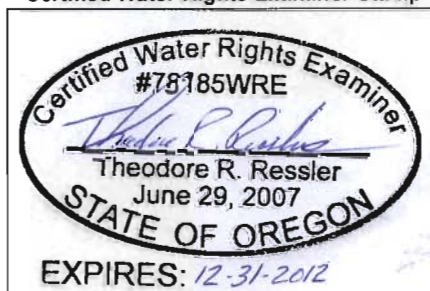

Disclaimer

This map was prepared for the purpose of identifying the location of a water right only and it is not intended to provide legal dimensions or location of property ownership lines.

Map Notes

Date: October 15, 2010
Data Sources: Oregon Geospatial Data
Cleaninghouse, METRO RLIS
Prepared By: GSI Water Solutions, Inc.

