


FINAL PROOF MAP
NW1/4NW1/4 and SW1/4NW1/4 Section 3
T. 39 S., R. 3 W., W.M., Jackson County, Oregon
For
Janet Barker
1974 Upper Applegate Road
Jacksonville, OR. 97530

RECEIVED
SEP 02 2005
WATER RESOURCES DEPT
SALEM, OREGON

Township 39 South, Range 3 West

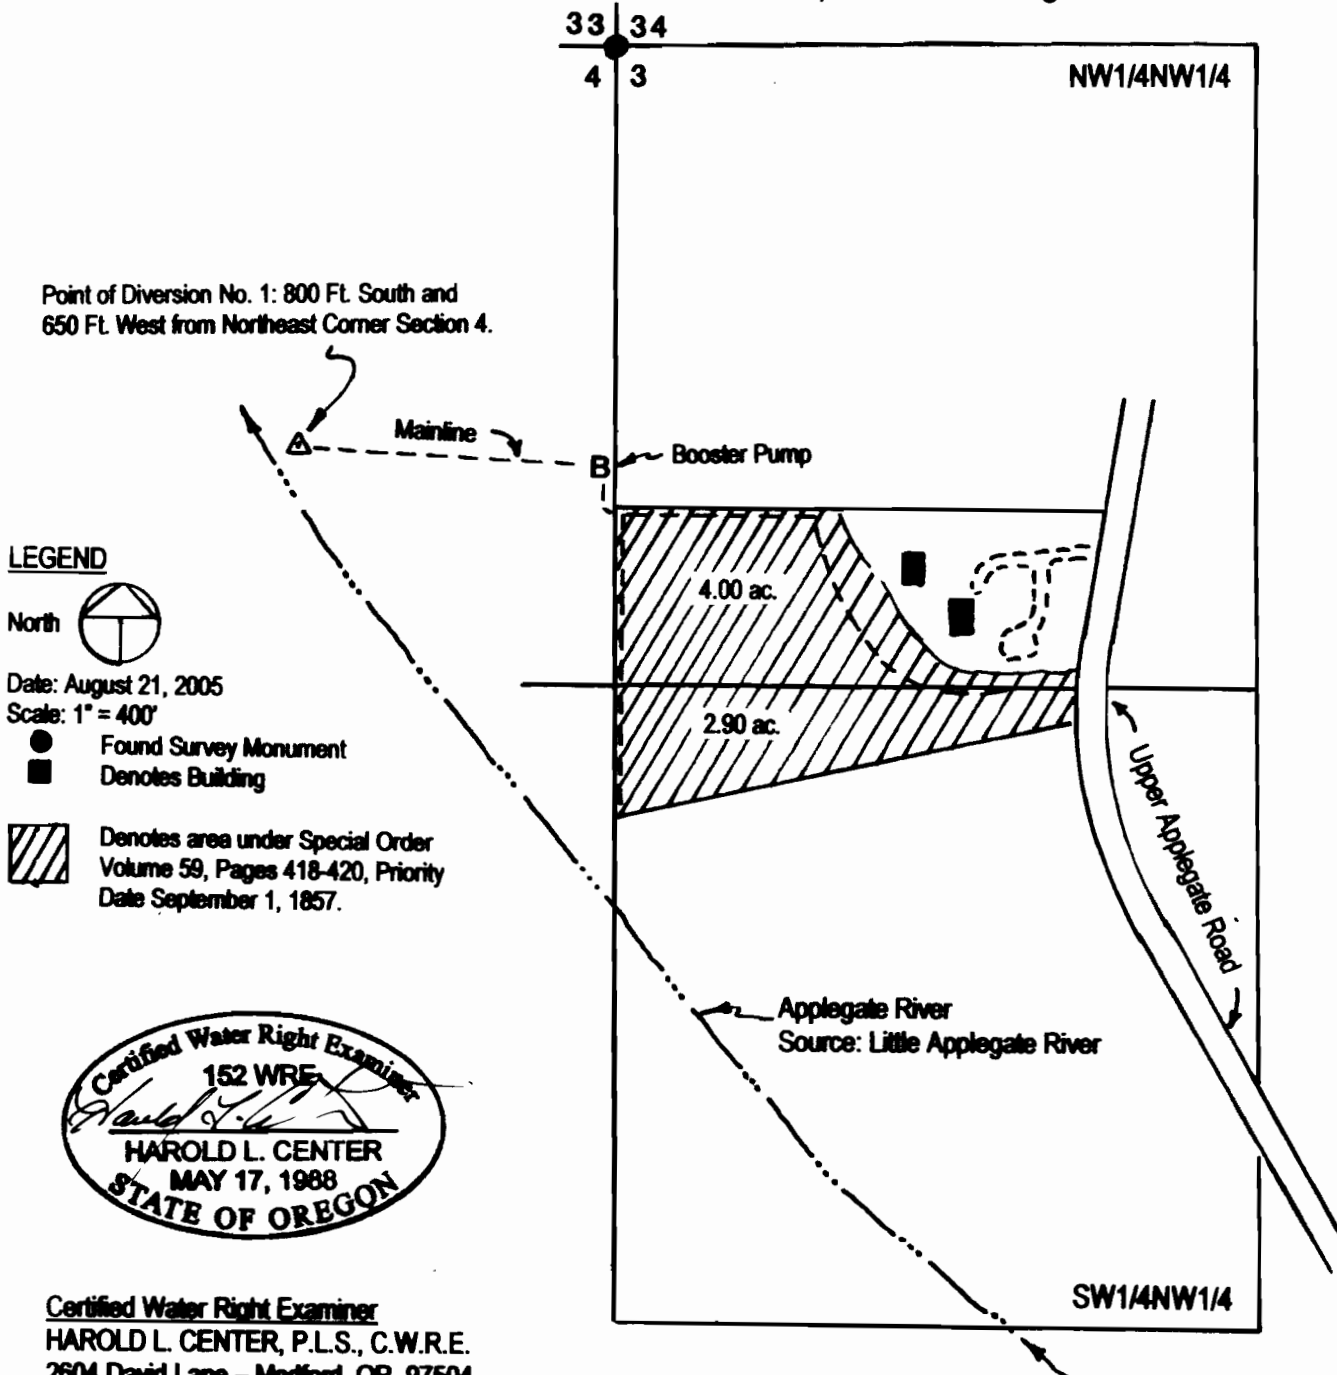

LEGEND



Date: August 21, 2005

Scale: 1" = 400'

- Found Survey Monument
- Denotes Building

▨ Denotes area under Special Order
 Volume 59, Pages 418-420, Priority
 Date September 1, 1857.




Certified Water Right Examiner
HAROLD L. CENTER, P.L.S., C.W.R.E.
 2604 David Lane - Medford, OR. 97504
 541-535-6108, Fax 541-535-8752
 Oregon C.W.R.E. No. 152
 Certificate Renewal Date, 12/31/05

This map was prepared for the purpose of identifying the location of a water right only and is not intended to provide legal dimensions or location of property ownership.

Farmers Ditch

T 39 S, R 3 W, W.M.

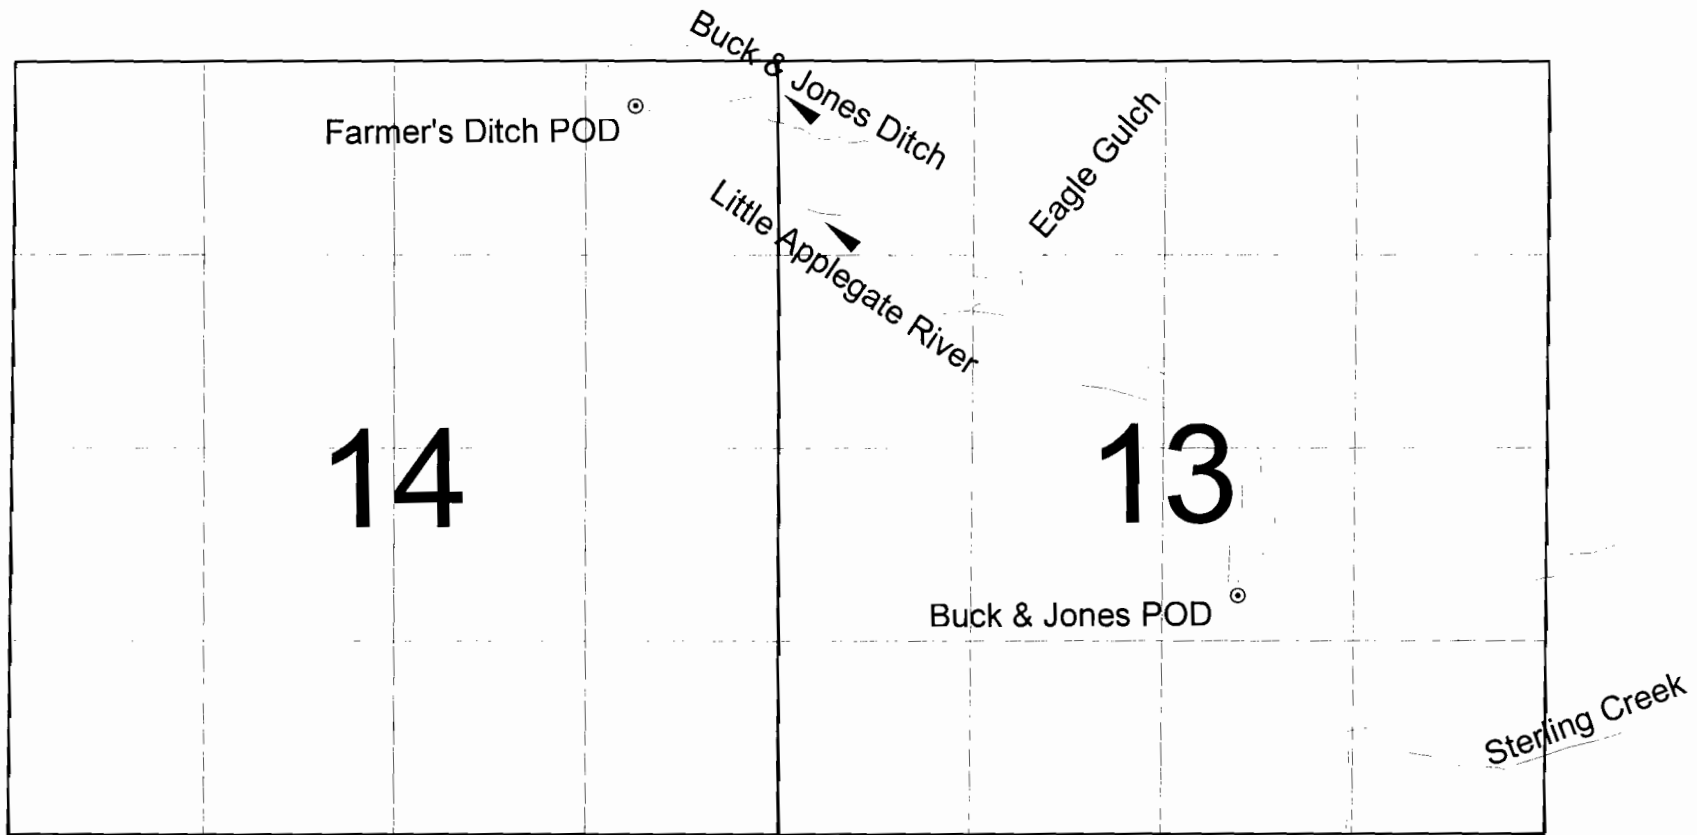

Final Proof Survey
under
T-8952

Little Applegate River



Farmer's Ditch POD - GPS coordinates: Latitude 42.18400, Longitude -123.0174
 Buck & Jones Ditch POD - GPS coordinates: Latitude 42.17508, Longitude -123.0018

