


TOWNSHIP 14 SOUTH, RANGE 14 EAST, W.M.

Section 26

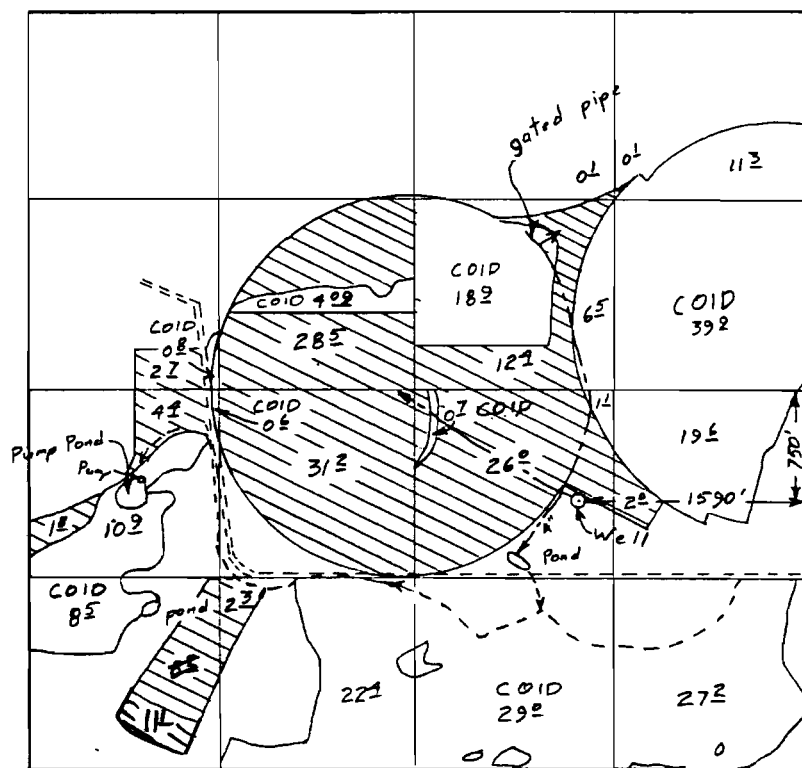


Scale 1" = 1320'

Surveyed August 16, 2000

Claim of Beneficial Use Map
for
LARK RANCH

App G-14023
Per G-13009

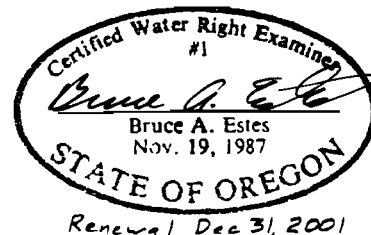

This map is for the purpose of
locating a water right only
and has no intent to provide
legal dimensions or the location
of property lines.

ESTES SURVEYS

PO Box 17519 60382 Arnold Rd
Salem, OR 97305-7519 Bend, OR 97702
(503) 585-7593 (541) 382-7391