




T37S R6W Sec 8

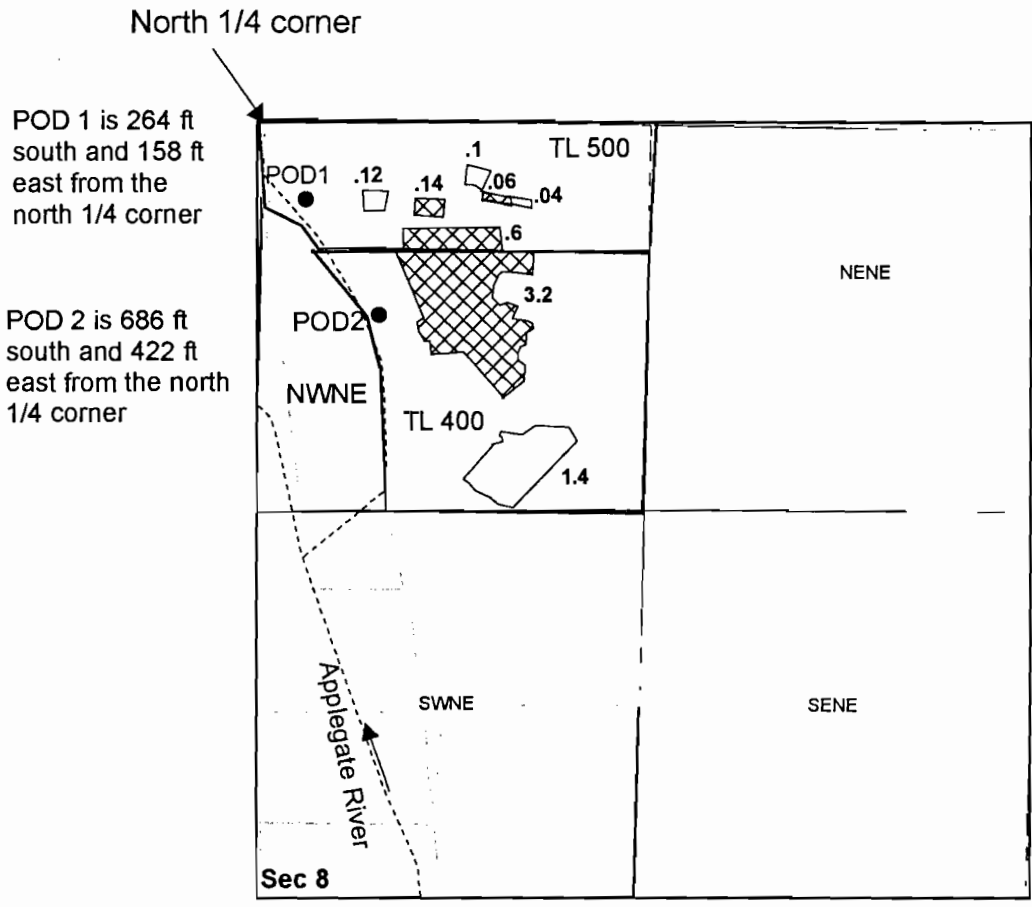

1 inch = 660 feet

-  Supplemental Only
-  Primary & Supplemental
*NC WRD
4-7-2011*

FINAL PROOF SURVEY UNDER

RECEIVED
APR 07 2011
WATER RESOURCES DEPT
SALEM OREGON

Application No. 62052 Permit No. 46138

IN NAME OF
Betty Jean Bolch