


# T. 9 S. R. 27 E. W. M.

N  
Scale 1" = 1320'

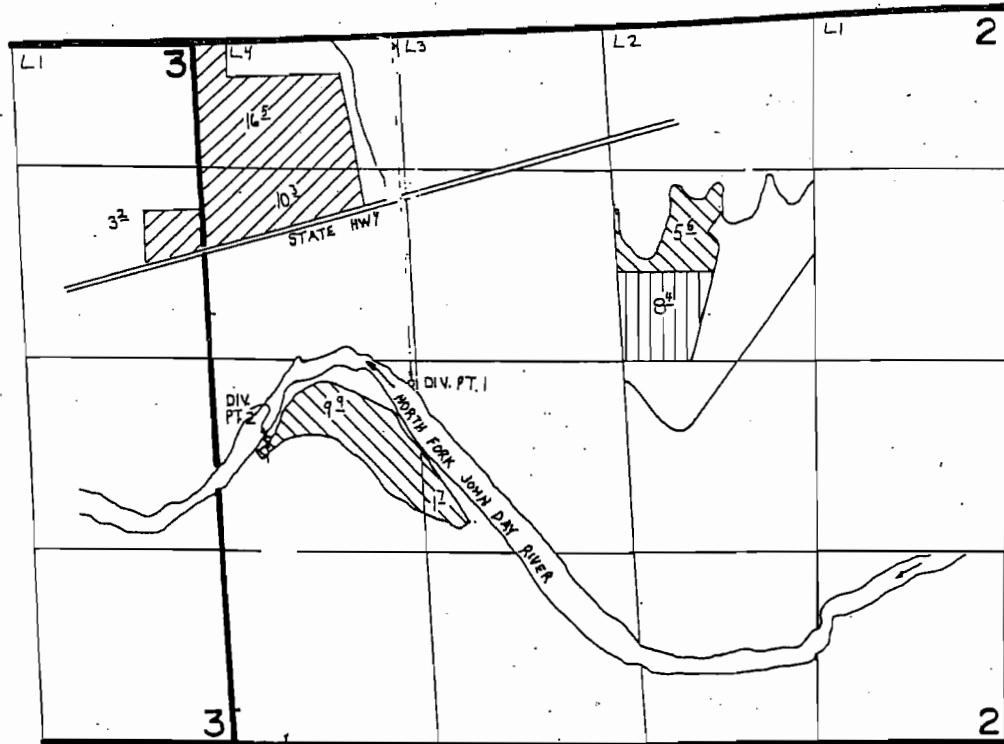

P-23848  


P-34472  


P-39980  


Points of Diversion are located as follows:  
 POD 1 - 2320 Feet South and 1550 Feet East from the NW Corner of Section 2  
 POD 2 - 2075 Feet North and 225 Feet East from the SW Corner of Section 2

## FINAL PROOF SURVEY UNDER

### TRANSFER 4495

IN NAME OF

**LEO FLOWER & LEONARD CARLSON**

Surveyed March 21, 1986, by V. Church

POD measurements  
amended 4-7-2011 DC  
123 R SC