


RECEIVED

JAN 18 2011

WATER RESOURCES DEPT  
SALEM, OREGON

# T35S R6W

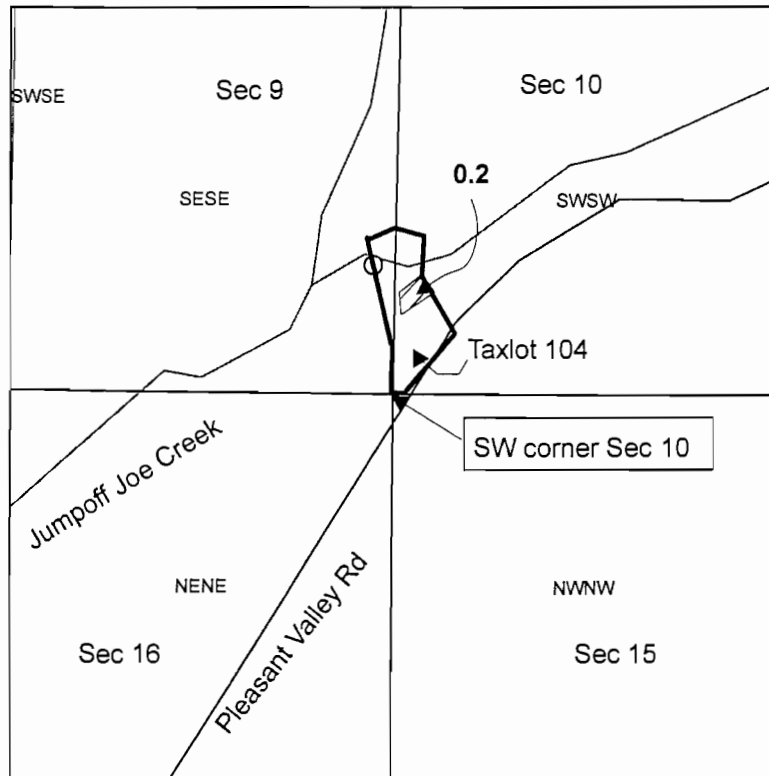

1 inch = 660 feet

## Final Proof Survey

UNDER

**(C48721) T5827**

**Applicant: Elizabeth Van Gordon**

POD is 440 ft north  
and 71 ft west  
from SW corner of  
Sec 10