


# T38S R5W

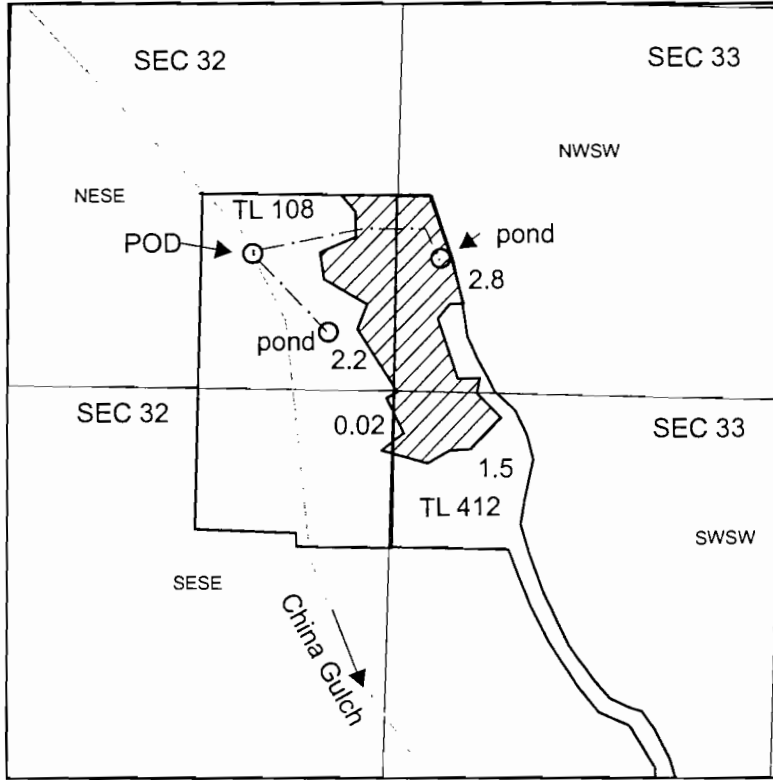

1 inch = 660 feet

Mainline - - - -

POD is 486 ft west and 443 feet north  
from the northeast corner of the  
SESE quarter of Sec 32.

## FINAL PROOF SURVEY

UNDER

(C16355) T5829

Applicant: Bob L. Hopper

RECEIVED

JAN 27 2011

SATISFACTION RECEIPT  
SALTY SPRING