




T.16 S., R.5 W. S.27 W.M.

1" = 400'

The purpose of this map is to identify the location of the waterright. It is not intended to provide information relative to the location of the property ownership boundary lines,

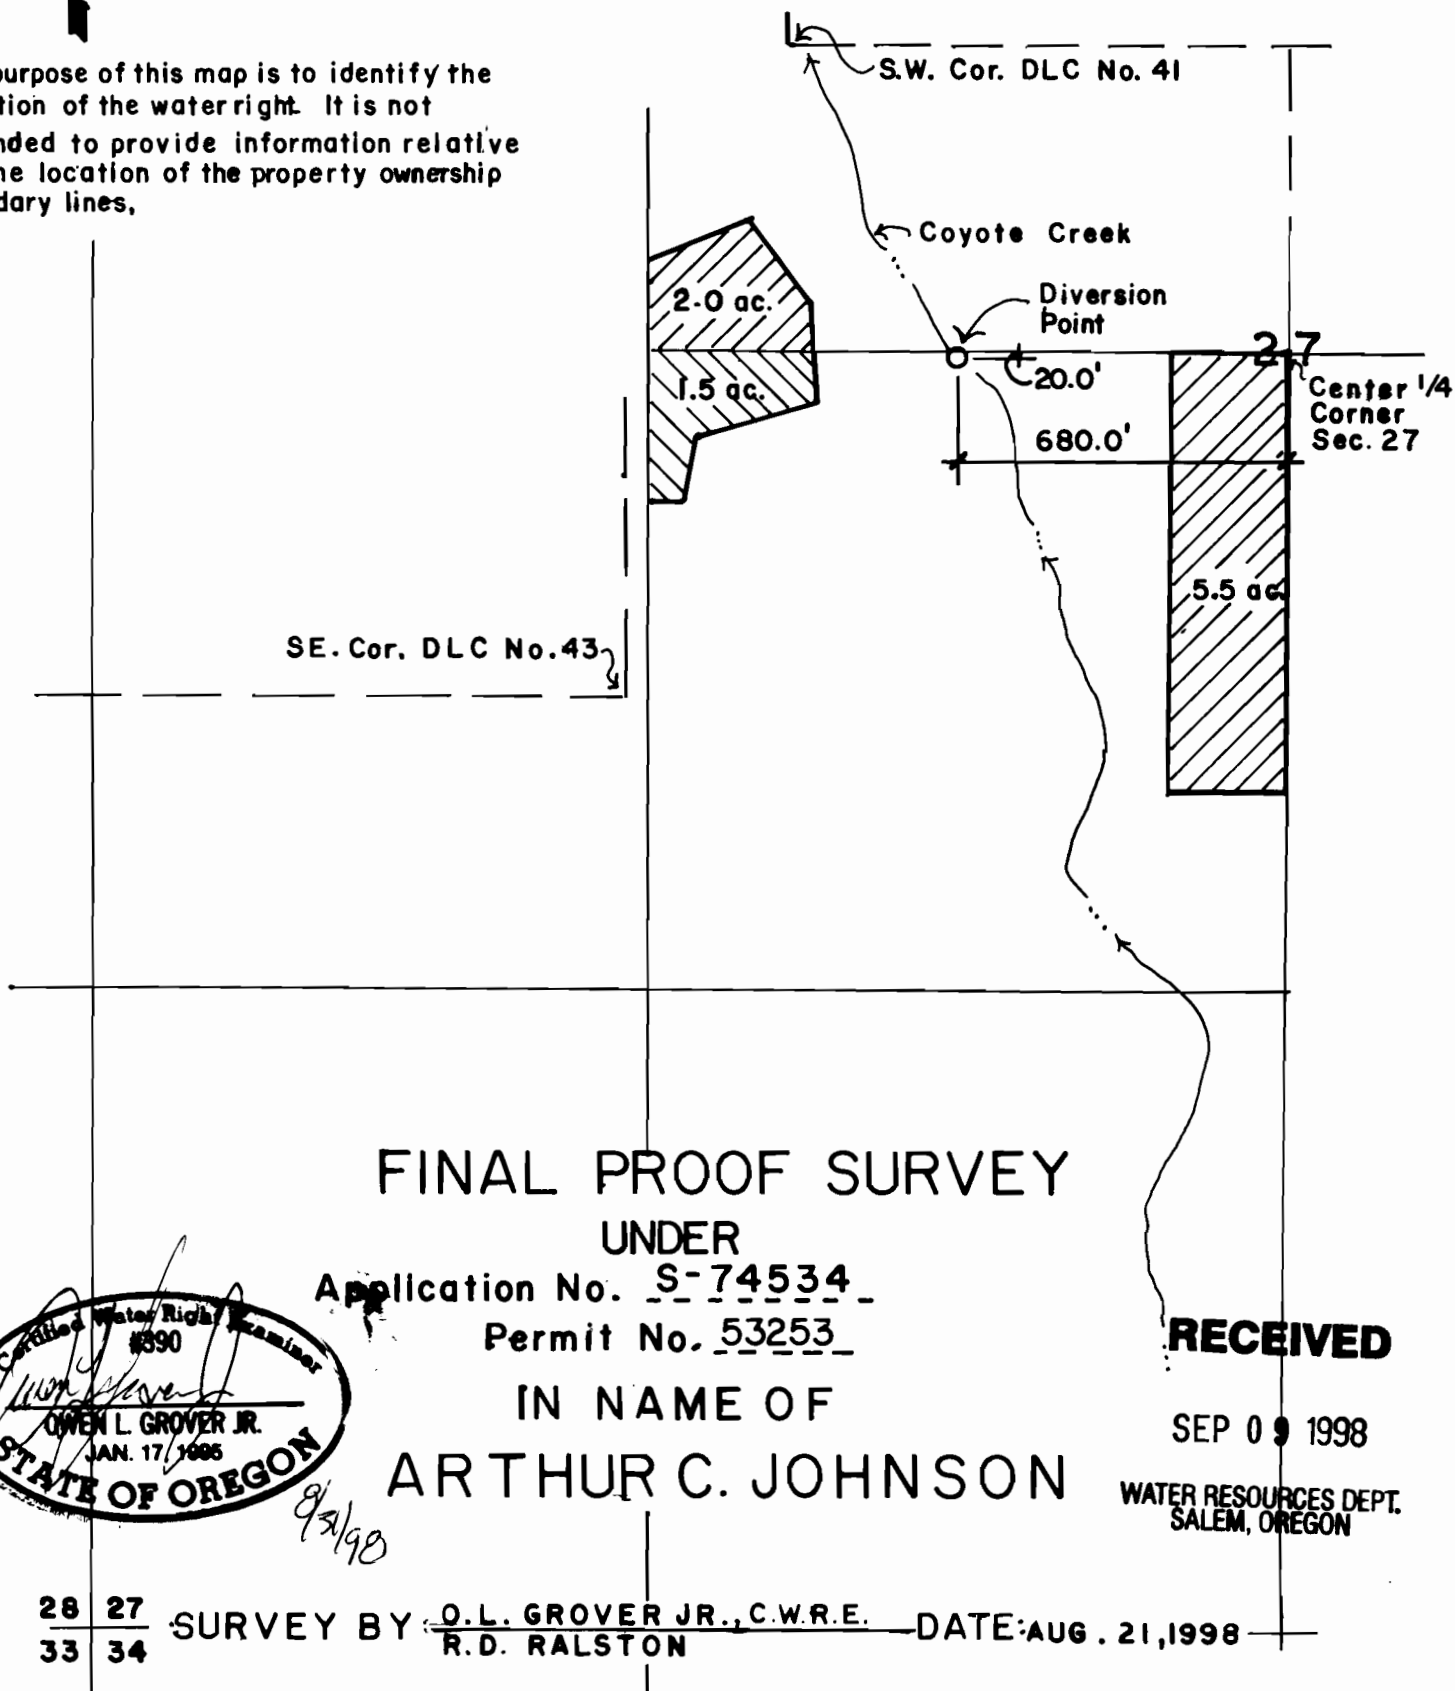

FINAL PROOF SURVEY


UNDER

Application No. S-74534

Permit No. 53253

IN NAME OF

ARTHUR C. JOHNSON

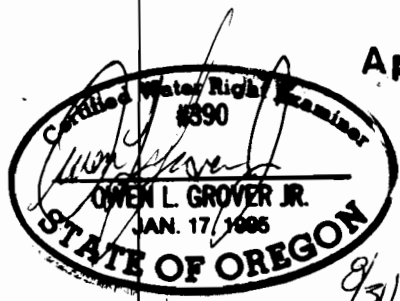

RECEIVED

SEP 09 1998

WATER RESOURCES DEPT.
SALEM, OREGON

28 27 SURVEY BY O.L. GROVER JR., C.W.R.E. DATE: AUG. 21, 1998
33 34 R.D. RALSTON