


4

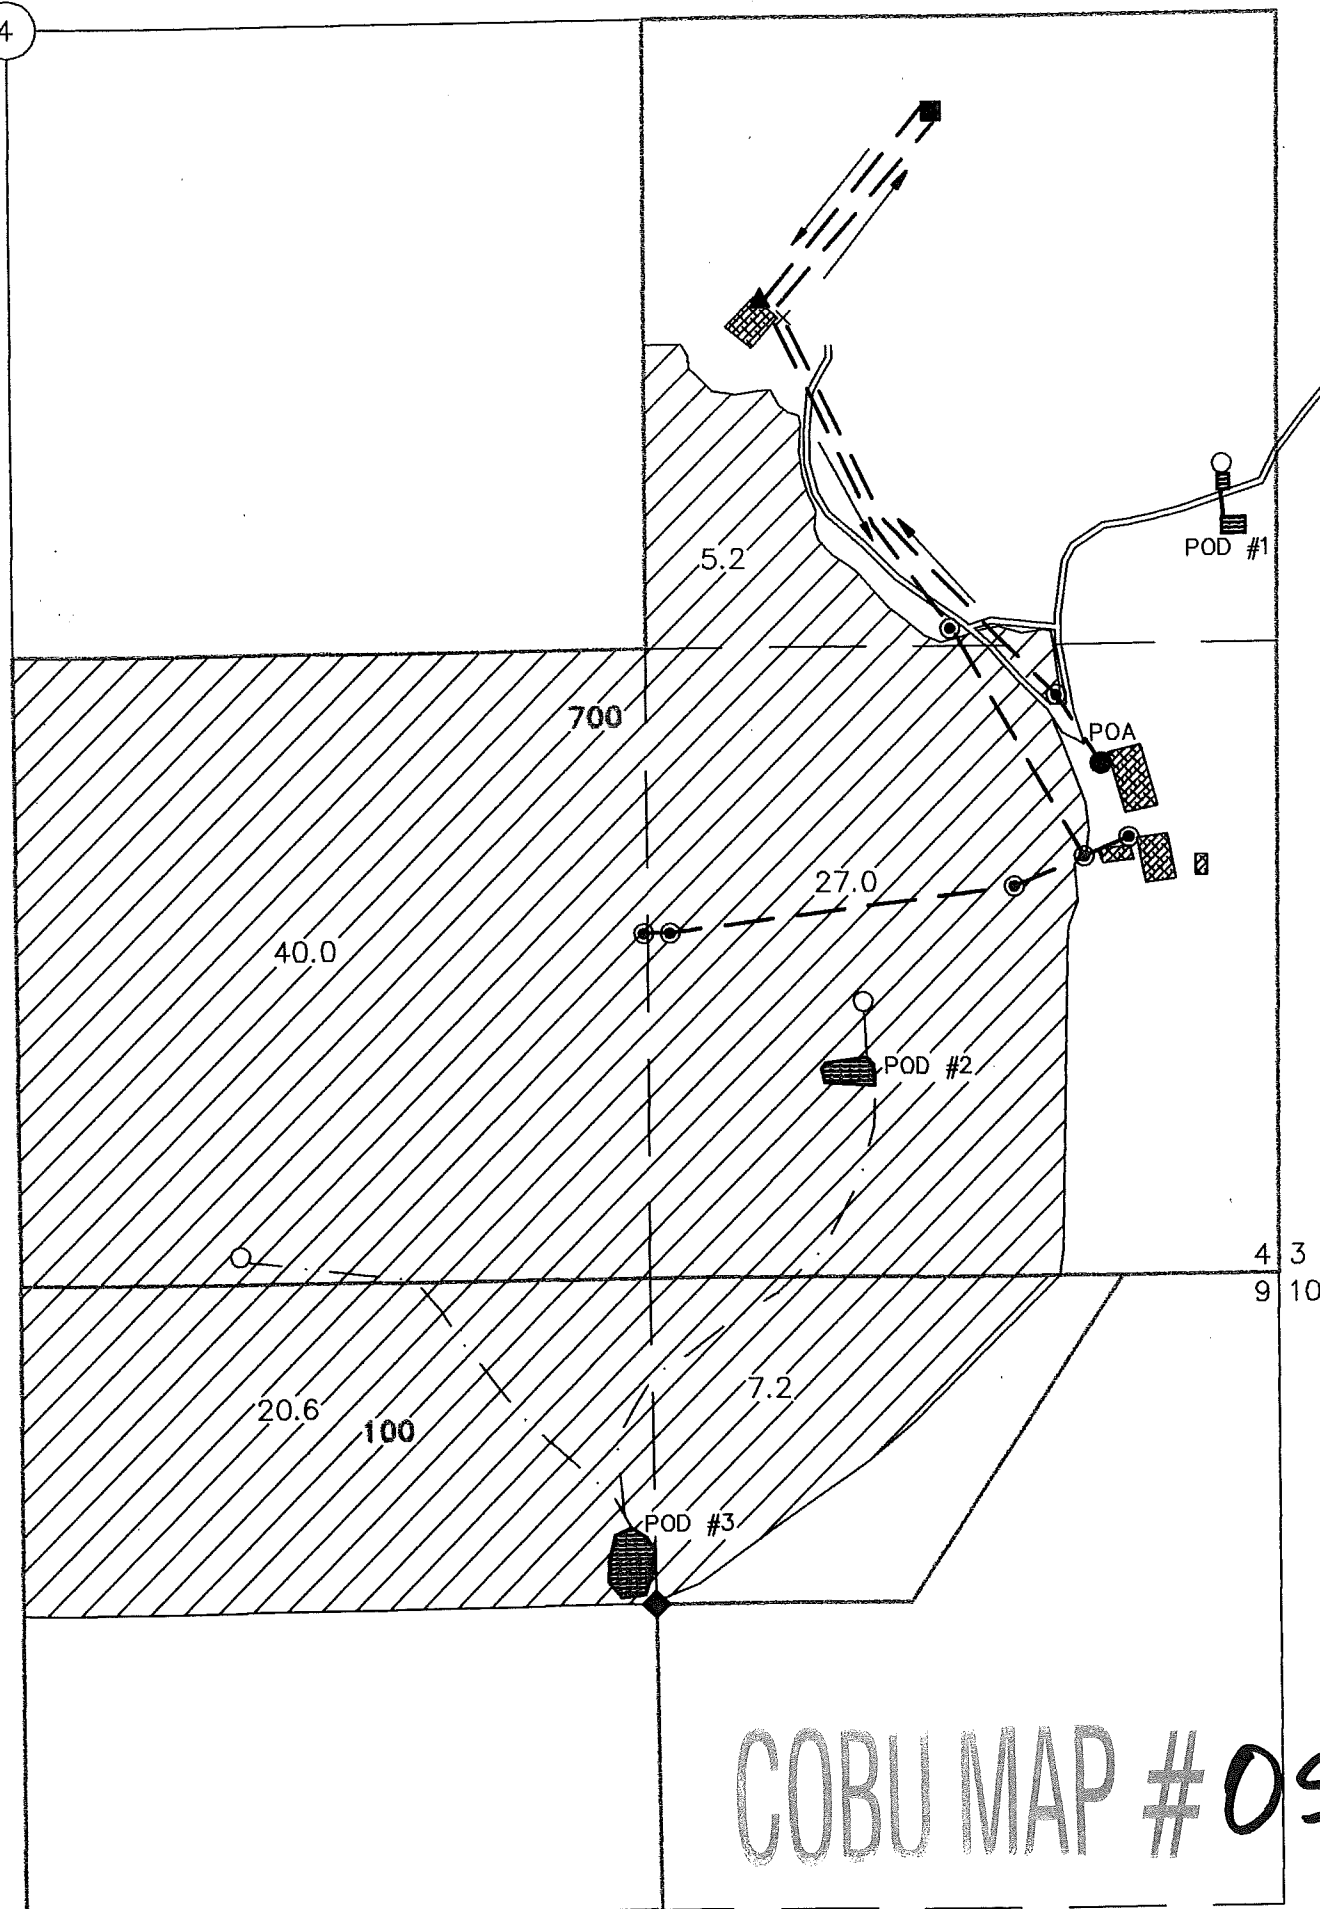

FINAL PROOF MAP

TO ADD A POINT OF APPROPRIATION AND PLACE OF USE FOR PERMIT G-15059 OR AZ HOLDINGS, LLC

TOWNSHIP 21 SOUTH, RANGE 3 EAST, SECTIONS 4 AND 9, W.M.
TAX LOTS: 700 AND 100

● POA (LANE 24240)

WELL IN THE SE 1/4 OF THE SE 1/4 OF SECTION 4
LOCATED 245 FEET WEST AND 1180 FEET NORTH FROM THE
SOUTHEAST CORNER OF SECTION 4, TOWNSHIP 21 SOUTH,
RANGE 3 EAST, W.M., LANE COUNTY, OREGON

NEWLY INSTALLED METER IS APPROXIMATELY 3 FEET NORTH
ALONG DELIVERY PIPE FROM WELL.

POD 1 (RES 1&2) R-13958

OUTLET FROM DAM 1 & 2 IN THE NE 1/4 OF THE SE 1/4
OF SECTION 4 DAM 1 LOCATED 100 FEET WEST AND 1625
FEET NORTH FROM THE SOUTHEAST CORNER OF SECTION 4,
TOWNSHIP 21 SOUTH, RANGE 3 EAST, W.M., LANE COUNTY,
OREGON

SPILLWAY IS ABOVE OUTLET AT APPROXIMATE CENTER OF DAM.

DAM 2 LOCATED 50 FEET WEST AND 1540 FEET NORTH FROM
THE SOUTHEAST CORNER OF SECTION 4, TOWNSHIP 21 SOUTH,
RANGE 3 EAST, W.M., LANE COUNTY, OREGON

POD 2 (POND 2) R-13334


POND IN THE SE 1/4 OF THE SE 1/4 OF SECTION 4
LOCATED 845 FEET WEST AND THE OUTLET IS 395 FEET
NORTH FROM THE SOUTHEAST CORNER OF SECTION 4,
TOWNSHIP 21 SOUTH, RANGE 3 EAST, W.M., LANE COUNTY,
OREGON

POD 3 (RES 3) R-13335

OUTLET OF DAM 3 IN THE NW 1/4 OF THE NE 1/4 OF
SECTION 9 AND THE OUTLET IS LOCATED 1370 FEET WEST
630 FEET SOUTH FROM THE NORTHEAST CORNER OF SECTION
9, TOWNSHIP 21 SOUTH, RANGE 3 EAST, W.M., LANE COUNTY,
OREGON

SPILLWAY IS APPROXIMATELY 25 FEET WEST ALONG CREST OF
DAM FROM OUTLET OF DAM.

SCALE: 1 INCH = 400 FEET

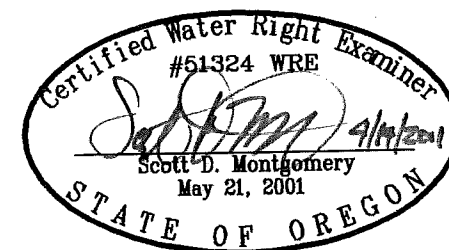

RENEWAL DATE: 12/31/2012

THIS MAP IS FOR THE PURPOSE OF LOCATING A WATER
RIGHT ONLY AND HAS NO INTENT TO PROVIDE LEGAL
DIMENSIONS OR THE LOCATION OF PROPERTY LINES

100.0 ACRES PRIMARY IRRIGATION, AS SHOWN

STREAM LINE
 PIPE LINE
 ROADWAY

SPRING
 PUMP STATION
 STORAGE/PRESSURE TANKS
 FIELD HYDRANT
 PROPERTY MONUMENT
 BUILDING
 RESERVOIR OR POND

RECEIVED
APR 18 2011

WATER RIGHT PERMIT
SALE/REASON

PREPARED FOR:

OR AZ HOLDINGS, LLC
7579 E. WHISPER TRAIL
SCOTTSDALE, AZ 85266-1538

PREPARED BY:



ALL POINTS ENGINEERING AND SURVEYING, INC.
P.O. BOX 767 (CRR) TERREBONNE, OR 97760
(541) 548-5833 www.APEandS.com