


# MAP OF OSCAR GARRELL'S DOMESTIC & IRRIGATION SYSTEMS

IN  
SECTIONS 29 & 30 Twp. 25S, RANGE 6 W., W.M.  
DOUGLAS COUNTY OREGON  
Office of  
H. L. EPPSTEIN  
COUNTY SURVEYOR

## CERTIFICATE OF SURVEYOR.

I, Ben B. Irving, of Wilbur Oregon, do hereby certify that this map was made from notes taken during an actual survey made by me on the fourth day of November 1922, and that it correctly represents the works described in the accompanying application, together with the location streams and other ditches in the immediate vicinity.

Oregon No. 240  
Nov. 8 1919  
Date of Registration

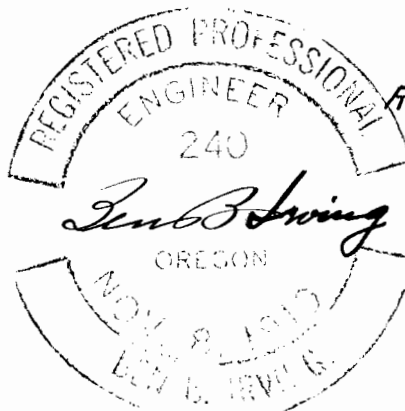

*Ben B. Irving*  
Registered Professional Engineer

8889  
5822