


T.4S., R.1W., W.M.

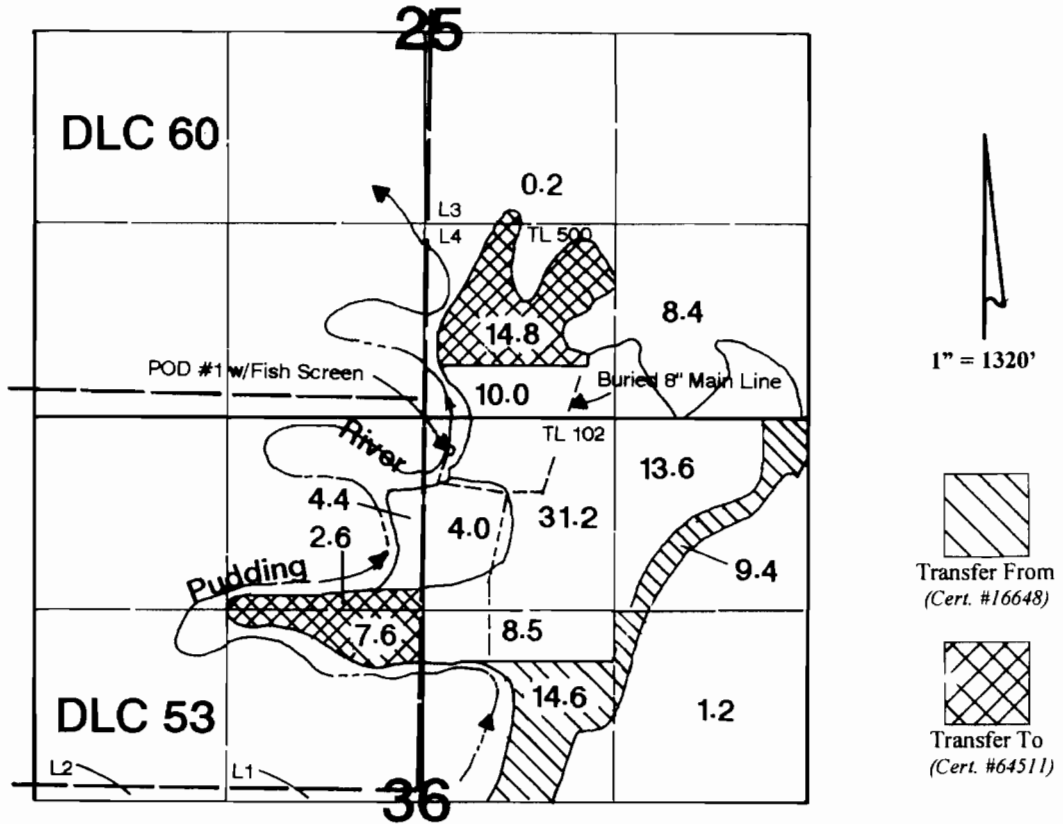

POD #1 is located 210' S & 190' E from the N1/4 corner of Section 36. (NE1/4-SE1/4, Sec. 36)


Claim of Beneficial Use

In the Name of

Eric & Lynda Strom

Transfer #: T-9868

Surveyed on October 7, 2010 by JM Schuette

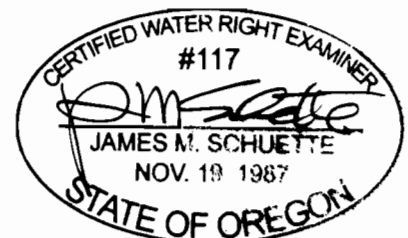

EXPIRES: 6/30/2012

Revised 4/26/2011

This Map was Prepared for the Purpose of Identifying the Location of a Water Right Only and is Not Intended to Provide Legal Dimensions or Location of Property Ownership Lines.