


T.10 S.R. 2 W.W.M.

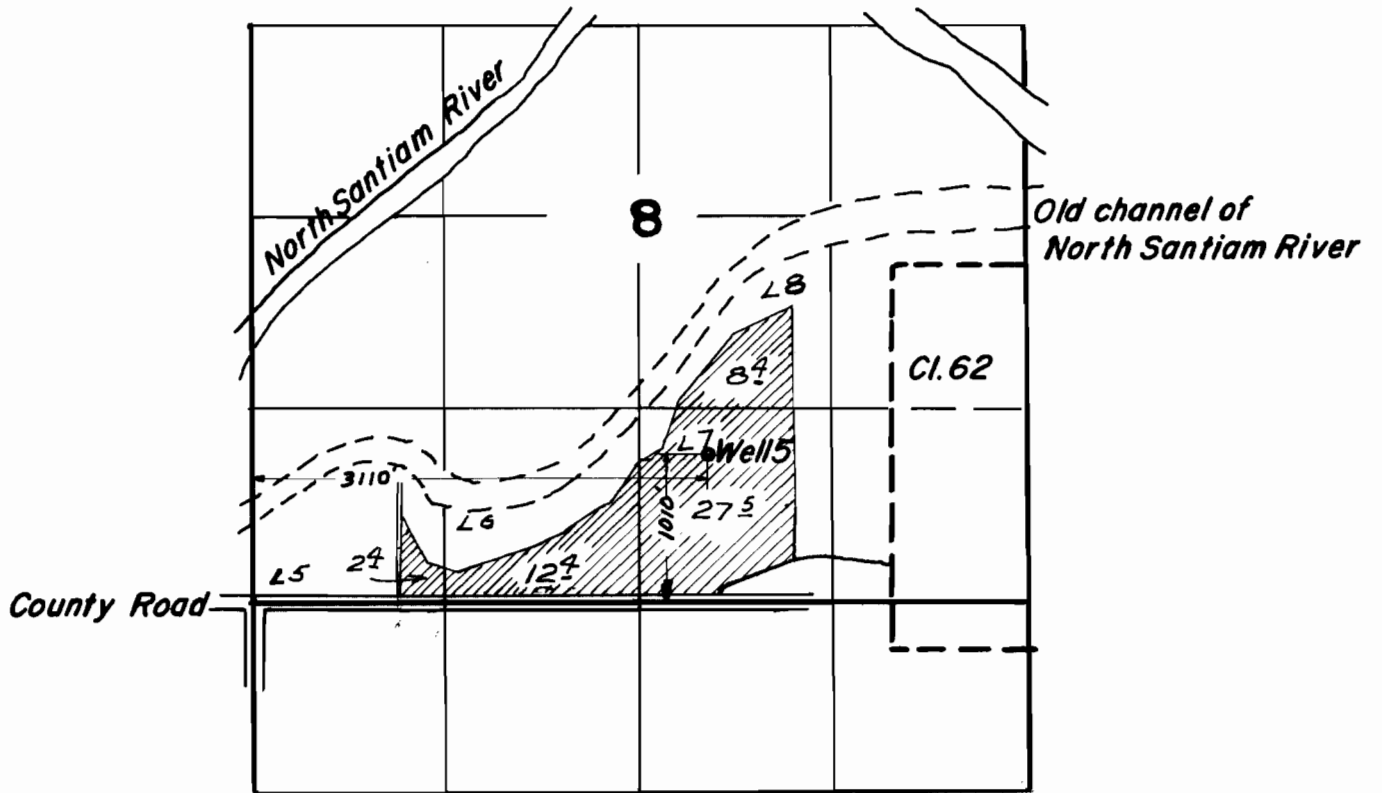

**FINAL PROOF SURVEY**  
UNDER

Application No. G-2.289 Permit No. G-2113  
IN NAME OF

***William Uppstad***

Surveyed Dec. 11, 1962, by F. Siegmund  
Jan. 13, 1966