


T.10S., R.2W., W.M.

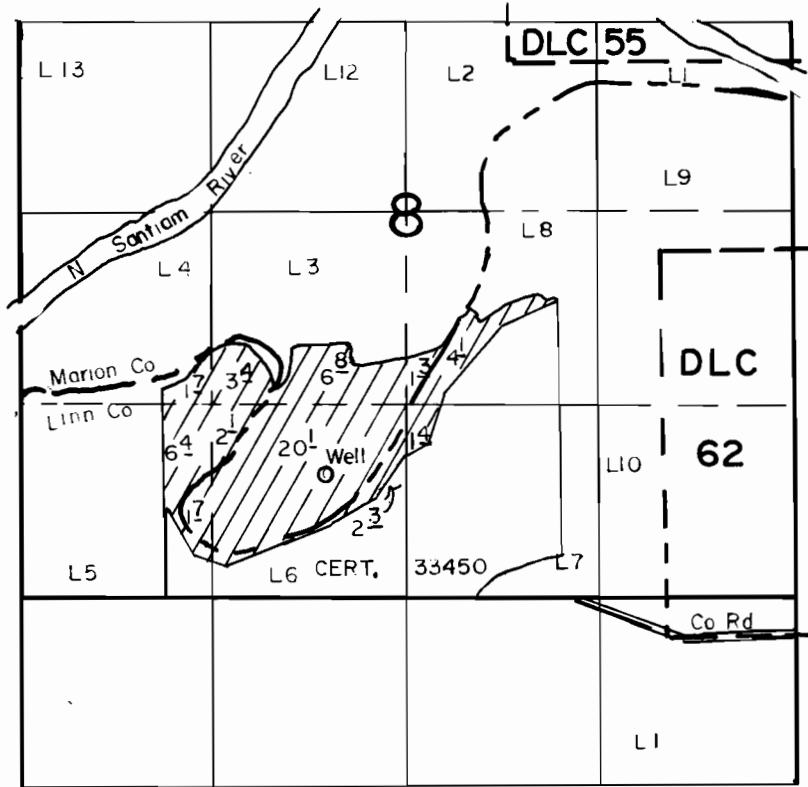

Well Loc 850' N & 2050' E From The SW Corner Of Section 8

SCALE: 1" = 1320'

FINAL PROOF SURVEY UNDER

Application No. G:11651.. Permit No.G:10727.....
IN NAME OF

.....KENNETH E. CUNNINGHAM.....

Surveyed AUG..25... 1989., by R.W.KLASSEN.....