


T. 10 S. R. 2 W. W. M.

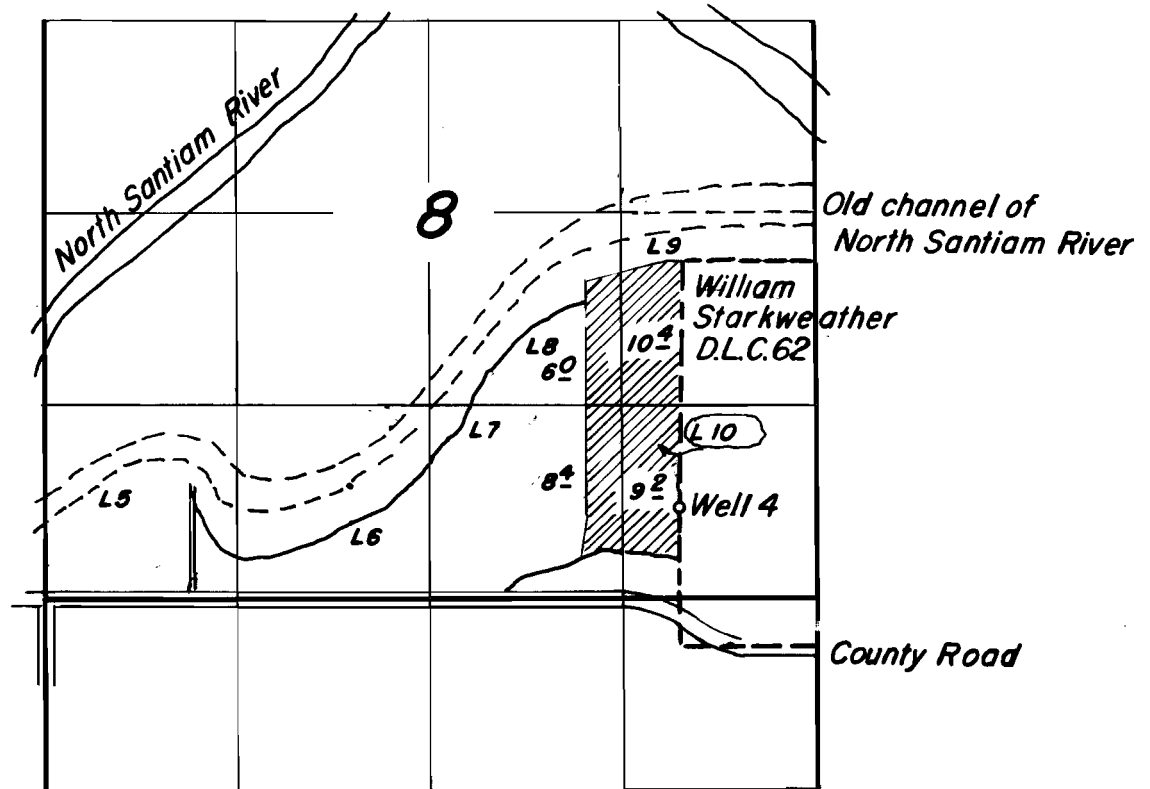

FINAL PROOF SURVEY
UNDER

Application No. *G-1644* Permit No. *G-1501*
IN NAME OF

William Uppstad

Surveyed *Dec. 11* 1962, by *Floyd L. Siegmund*