


T. 38 S., R. 3 W., W.M.

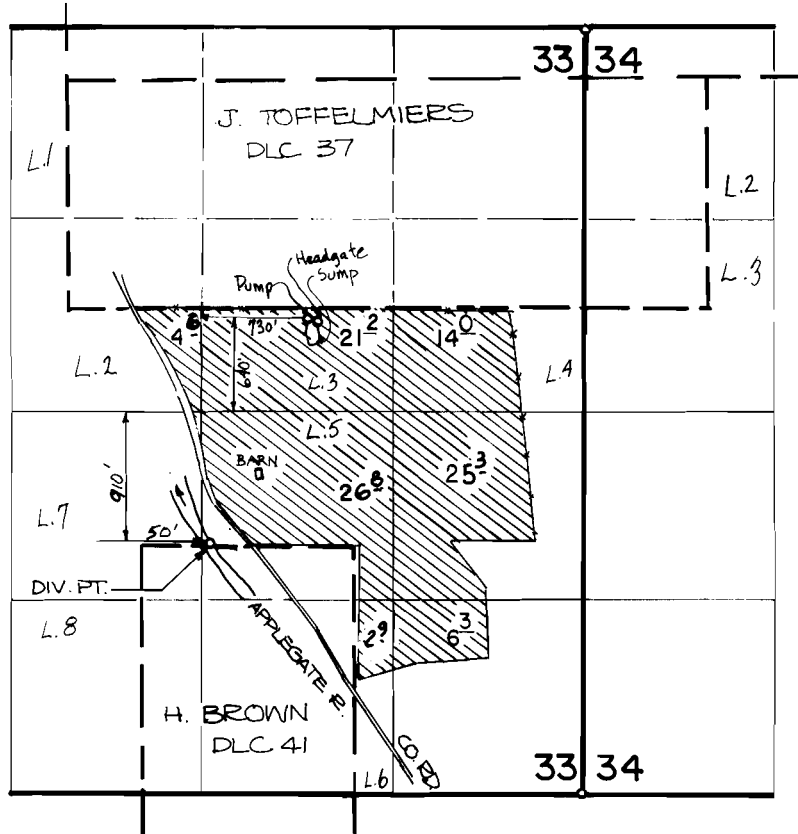

FINAL PROOF SURVEY UNDER

Application No. ~~G 8636~~ 62251 Permit No. ~~G 8003~~ 45539
 IN NAME OF

ELDA CRANE & WAYNE A. & LINDA HEALY

Surveyed MAY 18, 1983, by B. S. JAMES