


T. 32 S., R. 6 W., W.M., Section 5

Spring Box Diversion is:
92 ft. South and
2394 ft. East of the
W 1/4 cor. Sec 5

Pond Diversion is:
745 ft. North and
2266 ft. East of the
W 1/4 cor. Sec 5

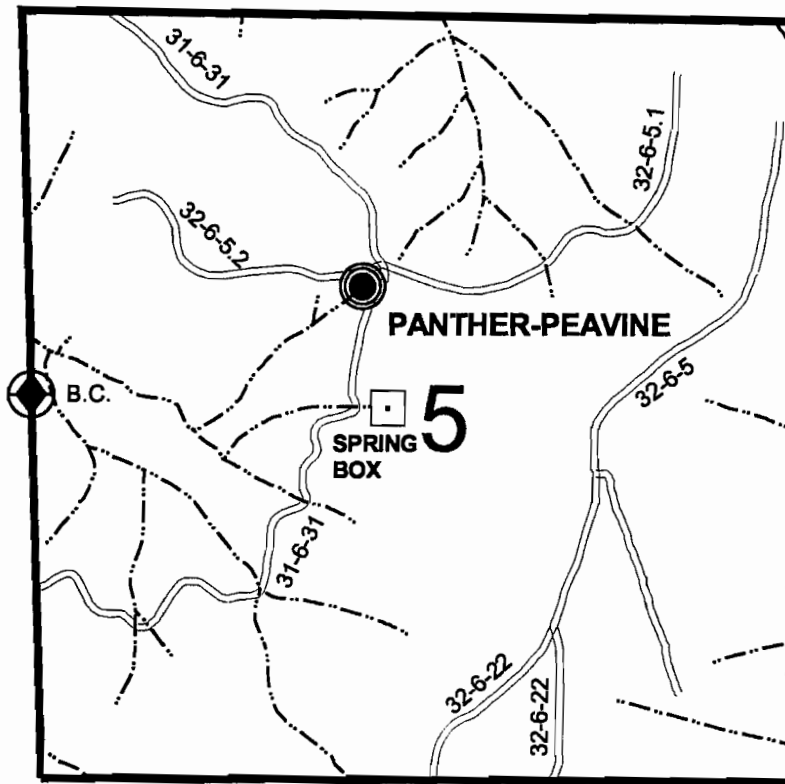

SCALE:
1" = 1320'

CLAIM OF BENEFICIAL USE MAP

in name of

UNITED STATES BUREAU OF LAND MANAGEMENT

Application No.: R - 70712

S - 70519


Permit No.: R - 11797

52282

RECEIVED

SEP 25 2000

WATER RESOURCES DEPT.
SALEM, OREGON

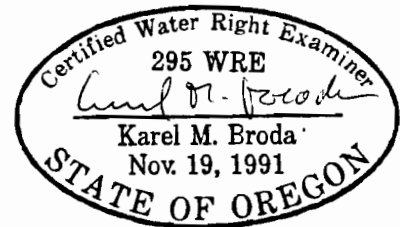

Expires: 12/31/01

SURVEYED: June 6, 2000

THIS MAP WAS PREPARED FOR THE PUPOSE OF IDENTIFYING THE LOCATION OF A WATER RIGHT ONLY
AND IS NOT INTENDED TO PROVIDE LEGAL DIMENSIONS OR LOCATION OF PROPERTY OWNERSHIP LINES.

U.S. Bureau of Land Management
Roseburg District Office
Division of Operations

Executed by:
Karel M. Broda, PE, CWRE
777 N.W. Garden Valley Blvd.
Roseburg, Oregon 97470